


1 LOCATION OF WATER WELL:	Fraction	Section Number	Township Number	Range Number
County: GRANT	SE 1/4 NW 1/4 SE 1/4	25	T 28 S	R 37 E/W

Distance and direction from nearest town or city street address of well if located within city?  
 2 miles east of Ulysses Kansas at City Landfill

2 WATER WELL OWNER: City Of Ulysses  
 RR#, St. Address, Box #: 115 West Grant Board of Agriculture, Division of Water Resources  
 City, State, ZIP Code: Ulysses, Kansas 67880 Application Number:

3 LOCATE WELL'S LOCATION WITH AN "X" IN SECTION BOX:

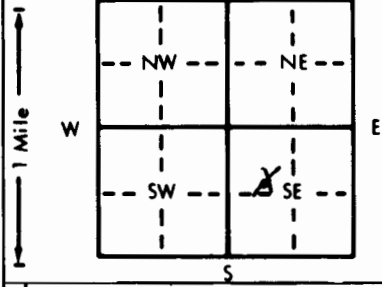

4 DEPTH OF COMPLETED WELL: 90 ft. ELEVATION:  
 Depth(s) Groundwater Encountered 1. 80 ft. 2. ft. 3. ft.  
 WELL'S STATIC WATER LEVEL: 80 ft. below land surface measured on mo/day/yr 7/3/93  
 Pump test data: Well water was ft. after hours pumping gpm  
 Est. Yield gpm: Well water was ft. after hours pumping gpm  
 Bore Hole Diameter: 8 in. to 9.0 ft., and in. to ft.  
 WELL WATER TO BE USED AS:  
 5 Public water supply 8 Air conditioning 11 Injection well  
 1 Domestic 3 Feedlot 6 Oil field water supply 9 Dewatering 12 Other (Specify below)  
 2 Irrigation 4 Industrial 7 Lawn and garden only 10 Monitoring well  
 Was a chemical/bacteriological sample submitted to Department? Yes No X; If yes, mo/day/yr sample was submitted  
 Water Well Disinfected? Yes No X

5 TYPE OF BLANK CASING USED:  
 1 Steel 3 RMP (SR) 5 Wrought iron 8 Concrete tile CASING JOINTS: Glued Clamped  
 2 PVC 4 ABS 6 Asbestos-Cement 9 Other (specify below) Welded  
 7 Fiberglass Threaded X

Blank casing diameter: 4 in. to 9.0 ft., Dia. in. to ft., Dia. in. to ft.  
 Casing height above land surface: 36 in., weight lbs./ft. Wall thickness or gauge No. Schedule 40

TYPE OF SCREEN OR PERFORATION MATERIAL:  
 1 Steel 3 Stainless steel 5 Fiberglass 7 PVC 10 Asbestos-cement  
 2 Brass 4 Galvanized steel 6 Concrete tile 8 RMP (SR) 11 Other (specify)  
 12 None used (open hole)

SCREEN OR PERFORATION OPENINGS ARE:  
 1 Continuous slot 3 Mill slot 5 Gauzed wrapped 8 Saw cut 11 None (open hole)  
 2 Louvered shutter 4 Key punched 6 Wire wrapped 9 Drilled holes  
 7 Torch cut 10 Other (specify)

SCREEN-PERFORATED INTERVALS: From 70 ft. to 90 ft., From ft. to ft.  
 GRAVEL PACK INTERVALS: From 65 ft. to 9.0 ft., From ft. to ft.

6 GROUT MATERIAL: 1 Neat cement 2 Cement grout 3 Bentonite 4 Other  
 Grout intervals: From 1 ft. to 65 ft., From ft. to ft., From ft. to ft.  
 What is the nearest source of possible contamination:  
 1 Septic tank 4 Lateral lines 7 Pit privy 10 Livestock pens 14 Abandoned water well  
 2 Sewer lines 5 Cess pool 8 Sewage lagoon 11 Fuel storage 15 Oil well/Gas well  
 3 Watertight sewer lines 6 Seepage pit 9 Feedyard 12 Fertilizer storage 16 Other (specify below)  
 13 Insecticide storage 50 SANITARY LANDFILL

Direction from well? SOUTH How many feet?

FROM	TO	LITHOLOGIC LOG	FROM	TO	PLUGGING INTERVALS
0	3	Top Soil (dark)	0	65	vo clay Grout
3	22	Light Sands			
22	54	Coarse sands,			
54	65	Coarse sands light clay mix			
65	90	Coarse sands, Med rock			

7 CONTRACTOR'S OR LANDOWNER'S CERTIFICATION: This water well was (1) constructed, (2) reconstructed, or (3) plugged under my jurisdiction and was completed on (mo/day/year) 7/3/93 and this record is true to the best of my knowledge and belief. Kansas Water Well Contractor's License No. CO 535. This Water Well Record was completed on (mo/day/yr) 7/26/93 under the business name of Puyear Contractors Inc. by (signature) James O. Puyear