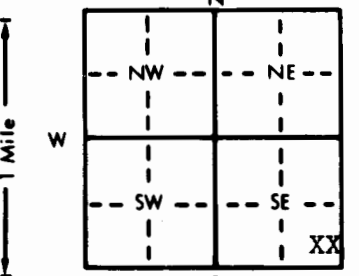


1 LOCATION OF WATER WELL: Fraction SE 1/4 Se 1/4 SE 1/4 Section Number 26 Township Number T 28 S Range Number R 37 EW

Distance and direction from nearest town or city street address of well if located within city?  
 From east end of Ulysses - 1/8 Mile North, 1/2 Mile East, 2/10ths Mile North & 200' West.

2 WATER WELL OWNER: Lamar Stuart  
 RR#, St. Address, Box #: 1004 N. College St. Board of Agriculture, Division of Water Resources  
 City, State, ZIP Code: Ulysses, Kansas 67880 Application Number:

3 LOCATE WELL'S LOCATION WITH AN "X" IN SECTION BOX:  
  
 4 DEPTH OF COMPLETED WELL: 50 ft. ELEVATION:  
 Depth(s) Groundwater Encountered 1. .... ft. 2. .... ft. 3. .... ft.  
 WELL'S STATIC WATER LEVEL ... 8 ... ft. below land surface measured on mo/day/yr ... 8-10-87 ...  
 Pump test data: Well water was ... ft. after ... hours pumping ... gpm  
 Est. Yield ... gpm: Well water was ... ft. after ... hours pumping ... gpm  
 Bore Hole Diameter ... 12 1/2 ... in. to ... 50 ... ft., and ... in. to ... ft.  
 WELL WATER TO BE USED AS: 5 Public water supply 8 Air conditioning 11 Injection well  
 ① Domestic 3 Feedlot 6 Oil field water supply 9 Dewatering ② Other (Specify below)  
 2 Irrigation 4 Industrial 7 Lawn and garden only 10 Observation well ... Stock Well ...  
 Was a chemical/bacteriological sample submitted to Department? Yes.....No...X.....; If yes, mo/day/yr sample was submitted  
 Water Well Disinfected? Yes X No

5 TYPE OF BLANK CASING USED:  
 1 Steel 3 RMP (SR) 5 Wrought iron 8 Concrete tile CASING JOINTS: Glued ..... Clamped .....  
 ② PVC 4 ABS 6 Asbestos-Cement 9 Other (specify below) Welded .....  
 7 Fiberglass ..... Threaded .....  
 Blank casing diameter ..... 5 ..... in. to ..... 34 ..... ft., Dia ..... in. to ..... ft., Dia ..... in. to ..... ft.  
 Casing height above land surface ..... 12 ..... in., weight ..... 2.84 ..... lbs./ft. Wall thickness or gauge No. ... SDR21 ...  
 TYPE OF SCREEN OR PERFORATION MATERIAL:  
 1 Steel 3 Stainless steel 5 Fiberglass ⑦ PVC 10 Asbestos-cement  
 2 Brass 4 Galvanized steel 6 Concrete tile 8 RMP (SR) 11 Other (specify) .....  
 9 ABS 12 None used (open hole)  
 SCREEN OR PERFORATION OPENINGS ARE:  
 1 Continuous slot ③ Mill slot 5 Gauzed wrapped ⑧ Saw cut 11 None (open hole)  
 2 Louvered shutter 4 Key punched 6 Wire wrapped 9 Drilled holes  
 7 Torch cut 10 Other (specify) .....  
 SCREEN-PERFORATED INTERVALS: From ... 34 ... ft. to ... 50 ... ft., From ... ft. to ... ft.  
 From ... ft. to ... ft., From ... ft. to ... ft.  
 GRAVEL PACK INTERVALS: From ... 10 ... ft. to ... 50 ... ft., From ... ft. to ... ft.  
 From ... ft. to ... ft., From ... ft. to ... ft.

6 GROUT MATERIAL: 1 Neat cement ② Cement grout 3 Bentonite 4 Other .....  
 Grout Intervals: From ... 0 ... ft. to ... 20 ... ft., From ... ft. to ... ft., From ... ft. to ... ft.  
 What is the nearest source of possible contamination:  
 1 Septic tank 4 Lateral lines 7 Pit privy 10 Livestock pens 14 Abandoned water well  
 2 Sewer lines 5 Cess pool 8 Sewage lagoon 11 Fuel storage 15 Oil well/Gas well  
 3 Watertight sewer lines 6 Seepage pit 9 Feedyard 12 Fertilizer storage 16 Other (specify below)  
 13 Insecticide storage ... N/A ...  
 Direction from well? How many feet?

FROM	TO	LITHOLOGIC LOG	FROM	TO	LITHOLOGIC LOG
		See attached log			

7 CONTRACTOR'S OR LANDOWNER'S CERTIFICATION: This water well was ① constructed, (2) reconstructed, or (3) plugged under my jurisdiction and was completed on (mo/day/year) ... 8-10-87 ... and this record is true to the best of my knowledge and belief. Kansas Water Well Contractor's License No. ... 208 ... This Water Well Record was completed on (mo/day/yr) ... 10-9-87 ... under the business name of Minter-Wilson Drilling Co., Inc. by (signature) *Nora Keller*

INSTRUCTIONS: Use typewriter or ball point pen. PLEASE PRESS FIRMLY and PRINT clearly. Please fill in blanks, underline or circle the correct answers. Send top three copies to Kansas Department of Health and Environment, Bureau of Water Protection, Topeka, Kansas 66620-7320, Telephone: 913-862-9360. Send one to WATER WELL OWNER and retain one for your records.

OFFICE USE ONLY  
T  
R  
EW  
SEC.  
1/4  
1/4  
1/4

The  
Professionals

# MINTER-WILSON DRILLING CO.

INCORPORATED

and Domestic  
Water Systems  
Complete Installation  
and Repairing

Phone 276-8269 • P.O. Box A • GARDEN CITY, KANSAS 67846

STUART  
Lamar Stewart  
Grant County  
8-10-87

Location: SE $\frac{1}{4}$  26-28-37 - From east end of Ulysses  
1/8 N.,  $\frac{1}{2}$  E., 2/10ths N. & 200 ft. W.

Static Water Level - 8'

### Test #1

0	3	Top soil	Ø1
3	31	Fine sand - loose	Ø7
31	37	Fine to medium sand	Ø5
37	44	Fine to medium sand & gravel	17
44	45	Blue shale	19

12 $\frac{1}{2}$ " Hole

5" PVC

34' Plain

16' Perf.

50' Well