


1 LOCATION OF WATER WELL: Fraction NE 1/4 NW 1/4 NW 1/4 Section Number 34 Township Number T 28 S Range Number R 37 EW

Distance and direction from nearest town or city street address of well if located within city? 525 S. Missouri Street

2 WATER WELL OWNER: Brown-Dupree Oil Company RR#, St. Address, Box #: 111 E. Kansas City, State, ZIP Code: Ulysses, Kansas 67880 Board of Agriculture, Division of Water Resources Application Number:

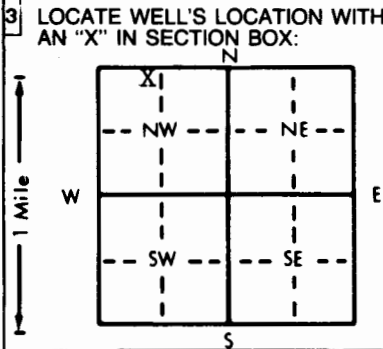

3 LOCATE WELL'S LOCATION WITH AN 'X' IN SECTION BOX: 4 DEPTH OF COMPLETED WELL: 79 ft. ELEVATION: 72 ft. below land surface measured on mo/day/yr

5 TYPE OF BLANK CASING USED: 1 Steel, 2 PVC, 3 RMP (SR), 4 ABS, 5 Wrought iron, 6 Asbestos-Cement, 7 Fiberglass, 8 Concrete tile, 9 Other (specify below), 10 Asbestos-cement, 11 Other (specify), 12 None used (open hole)

6 GROUT MATERIAL: 1 Neat cement, 2 Cement grout, 3 Bentonite, 4 Other. Grout Intervals: From 58 ft. to 53 ft., From 53 ft. to 0 ft.

Table with columns: FROM, TO, LITHOLOGIC LOG, FROM, TO, PLUGGING INTERVALS. Rows include lithologic logs like 'Clay, Light Brown, Lean' and 'Sand, Tan, Medium Grained'.

7 CONTRACTOR'S OR LANDOWNER'S CERTIFICATION: This water well was (1) constructed, (2) reconstructed, or (3) plugged under my jurisdiction and was completed on (mo/day/year) 9-10-92 and this record is true to the best of my knowledge and belief. Kansas Water Well Contractor's License No. 540. This Water Well Record was completed on (mo/day/yr) 5-19-93 under the business name of Prairie Land Environmental Remediation, Inc. (signature)

INSTRUCTIONS: Use typewriter or ball point pen. PLEASE PRESS FIRMLY and PRINT clearly. Please fill in blanks, underline or circle the correct answers. Send top three copies to Kansas Department of Health and Environment, Bureau of Water, Topeka, Kansas 66620-0001. Telephone: 913-296-5545. Send one to WATER WELL OWNER and retain one for your records.