


1 LOCATION OF WATER WELL: Fraction NE 1/4 NE 1/4 NE 1/4 Section Number 35 Township Number T 28 S Range Number R 37 EW

Distance and direction from nearest town or city street address of well if located within city?
 Ulysses 4 way stop 25 & 160: 2E & N into--

2 WATER WELL OWNER: Minter-Wilson Drilling Jim Randall
 RR#, St. Address, Box #: Box 669 Board of Agriculture, Division of Water Resources
 City, State, ZIP Code: Ulysses, KS 67880-0669 Application Number: Minter permitted

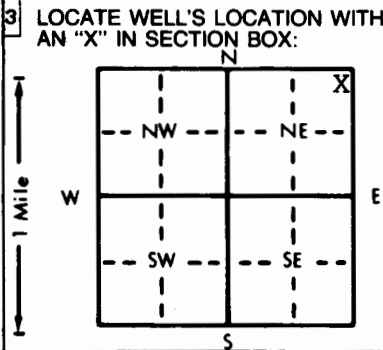

4 DEPTH OF COMPLETED WELL: 355 ft. ELEVATION: ... ft.
 Depth(s) Groundwater Encountered 1. 140 ft. 2. ... ft. 3. ... ft.
 WELL'S STATIC WATER LEVEL: 140 ft. below land surface measured on mo/day/yr 12/08/93
 Pump test data: Well water was 210' ft. after 1 hours pumping 90 gpm
 Est. Yield: 100 gpm: Well water was ... ft. after ... hours pumping ... gpm
 Bore Hole Diameter: 11 in. to 355 ft., and ... in. to ... ft.
 WELL WATER TO BE USED AS:
 Domestic 3 Feedlot 6 Oil field water supply 9 Dewatering 12 Other (Specify below)
 2 Irrigation 4 Industrial 7 Lawn and garden only 10 Monitoring well
 Was a chemical/bacteriological sample submitted to Department? Yes ... No X; If yes, mo/day/yr sample was submitted
 Water Well Disinfected? Yes X No

5 TYPE OF BLANK CASING USED:
 1 Steel 3 RMP (SR) 5 Wrought iron 8 Concrete tile CASING JOINTS: Glued X Clamped ...
 2 PVC 4 ABS 6 Asbestos-Cement 9 Other (specify below) Welded ...
 7 Fiberglass ... Threaded ...
 Blank casing diameter: 6 in. to 355 ft., Dia ... in. to ... ft., Dia ... in. to ... ft.
 Casing height above land surface: 24 in., weight 2,902 lbs./ft. Wall thickness or gauge No. 280 SDR21
 TYPE OF SCREEN OR PERFORATION MATERIAL:
 1 Steel 3 Stainless steel 5 Fiberglass 7 PVC 10 Asbestos-cement
 2 Brass 4 Galvanized steel 6 Concrete tile 8 RMP (SR) 11 Other (specify) ...
 12 None used (open hole)
 SCREEN OR PERFORATION OPENINGS ARE:
 1 Continuous slot 3 Mill slot 5 Gauzed wrapped 8 Saw cut 11 None (open hole)
 2 Louvered shutter 4 Key punched 6 Wire wrapped 9 Drilled holes
 7 Torch cut 10 Other (specify) ...
 SCREEN-PERFORATED INTERVALS: From 200 ft. to 355 ft. From ... ft. to ... ft.
 GRAVEL PACK INTERVALS: From 150 ft. to 355 ft. From ... ft. to ... ft.

6 GROUT MATERIAL: 1 Neat cement 2 Cement grout 3 Bentonite 4 Other Hole Plug
 Grout intervals: From 1 ft. to 20 ft. From ... ft. to ... ft. From ... ft. to ... ft.
 What is the nearest source of possible contamination:
 1 Septic tank 4 Lateral lines 7 Pit privy 10 Livestock pens 14 Abandoned water well
 2 Sewer lines 5 Cess pool 8 Sewage lagoon 11 Fuel storage 15 Oil well/Gas well
 3 Watertight sewer lines 6 Seepage pit 9 Feedyard 12 Fertilizer storage 16 Other (specify below)
 13 Insecticide storage
 Direction from well? How many feet?

FROM	TO	LITHOLOGIC LOG	FROM	TO	PLUGGING INTERVALS
0	20	Fine Sand			
20	100	Sandy Clay			
100	120	Fine Sand			
120	175	Sandy Clay			
175	220	Sand Strips to Sandstone			
220	240	Sandstone			
240	320	Sandy Clay			
320	340	Sandstone			
340	355	Sandstone to Black Clay			

7 CONTRACTOR'S OR LANDOWNER'S CERTIFICATION: This water well was (1) constructed, (2) reconstructed, or (3) plugged under my jurisdiction and was completed on (mo/day/year) 12/07/93 and this record is true to the best of my knowledge and belief. Kansas Water Well Contractor's License No. KWVCL-430 This Water Well Record was completed on (mo/day/yr) 12/07/93 under the business name of Howard Drilling Co. Box 806 Beaver, OK by (signature) Howard Drilling Co.

INSTRUCTIONS: Use typewriter or ball point pen. PLEASE PRESS FIRMLY and PRINT clearly. Please fill in blanks, underline or circle the correct answers. Send top three copies to Kansas Department of Health and Environment, Bureau of Water, Topeka, Kansas 66620-0001. Telephone: 913-296-5545. Send one to WATER WELL OWNER and retain one for your records.