

WATER WELL RECORD Form WWC-5 KSA 82a-1212


1 LOCATION OF WATER WELL: Fraction NW 1/4 NW 1/4 SE 1/4 Section Number 21 Township Number T 28 S Range Number R 37 W
 COUNTY: 034 GRANT

Distance and direction from nearest town or city street address of well if located within city?
 FROM ULYSSES; APPX 3/4 MILE WEST & 1 MILE NORTH

2 WATER WELL OWNER: CITY OF ULYSSES
 RR#, St. Address, Box # : 115 W. GRANT AVE. Board of Agriculture, Division of Water Resources
 City, State, ZIP code : ULYSSES, KS 67880- Application Number: GT 001 (Well #6)

3 LOCATE WELL'S LOCATION WITH AN "X" IN SECTION BOX:

4 DEPTH OF COMPLETED WELL 325 ELEVATION: 0
 Depth(s) Groundwater Encountered 1. 0 ft. 2. 0 ft. 3. 0 ft.

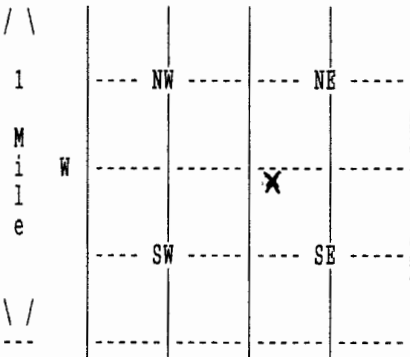

WELL'S STATIC WATER LEVEL 240 ft. below land surface measured on mo/day/yr 05/04/04
 Pump test data: Well water was 0 ft. after 0 hours pumping 0 gpm

Estimated Yield 0 gpm: Well water was 0 ft. after 0 hours pumping 0 gpm

Bore Hole Diameter 30 in. to ft., and in. to 0 ft.

WELL WATER WAS: 05 PUB. WTR SUP

Was a chemical/bacteriological sample submitted to department? No ;
 If yes, mo/day/yr sample was submitted Water well disinfected? Yes

5 TYPE OF BLANK CASING USED: 01 STEEL CASING JOINTS: WELDED
 Blank casing diameter 16 in. to 325 ft., Dia in. to 0 ft., Dia in. to 0 ft.
 Casing height above land surface 12 in., weight 63 lbs/ft. Wall thickness or gauge No. .375
 TYPE OF SCREEN OR PERFORATION MATERIAL: 01 STEEL
 SCREEN OR PERFORATION OPENINGS ARE: UNKNOWN

SCREEN PERFORATED INTERVALS: From 240 ft. to 270 ft., From 515 ft. to 547 ft.
 From 290 ft. to 325 ft., From 0 ft. to 0 ft.
 GRAVEL PACK INTERVALS: From ft. to ft., From 0 ft. to 0 ft.
 From ft. to ft., From 0 ft. to 0 ft.

6 GROUT MATERIAL 02 CEMENT GROUT
 Grout Intervals: From 7 ft. to 25 ft., From 0 ft. to 0 ft., From 0 ft. to 0 ft.
 What is the nearest source of possible contamination: NONE OBSERVED
 Direction from well? How many feet?

| FROM | TO | LITHOLOGIC LOG | FROM | TO | PLUGGING INTERVALS |
|------|----|----------------|------|-----|--------------------|
| | | | 0 | 7 | BACKFILL |
| | | | 7 | 25 | CONCRETE |
| | | | 25 | 200 | SOIL |
| | | | 200 | 365 | SAND |
| | | | 0 | 0 | |
| | | | 0 | 0 | |
| | | | 0 | 0 | |
| | | | 0 | 0 | |
| | | | 0 | 0 | |
| | | | 0 | 0 | |

7 CONTRACTOR'S OR LANDOWNER'S CERTIFICATION: This water well was Plugged under my jurisdiction and was completed on (mo/day/year) 11/09/04 and this record is true to the best of my knowledge and belief. Kansas Water Well Contractor's License No. 145 This Water Well Record was completed on (mo/day/yr) 04/14/05 under the business name of HENKLE DRILLING & SUPPLY by (signature) *Bruce J. Richmond*