


1 LOCATION OF WATER WELL: Fraction Lot 1 Blk NE Section Number 35 Township Number T 28 S Range Number 37 E/W

Distance and direction from nearest town or city street address of well if located within city?
1.5 East of Ulysses

2 WATER WELL OWNER: Sonia Rojas
RR# St. Address Box # : 3000 ERd 15 Board of Agriculture, Division of Water Resources
City, State, ZIP Code : Ulysses, KS 67880 Application Number:

3 LOCATE WELL'S LOCATION WITH: 4 DEPTH OF COMPLETED WELL 432 ft. ELEVATION:

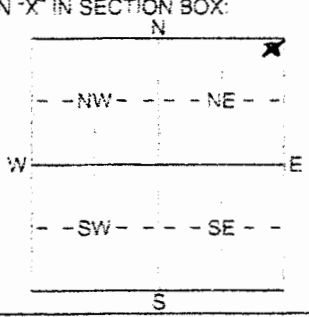

Depth(s) Groundwater Encountered 1 120 ft. 2 ft. 3 ft.
WELL'S STATIC WATER LEVEL 120 ft. below land surface measured on mo day/yr 8/17/06
Pump test data: Well water was ft. after hours pumping gpm
Est. Yield gpm: Well water was ft. after hours pumping gpm
WELL WATER TO BE USED AS:
 Domestic 3 Feedlot 6 Oil field water supply 9 Dewatering 12 Other (Specify below)
 Irrigation 4 Industrial 7 Domestic (lawn & garden) 10 Monitoring well
Was a chemical bacteriological sample submitted to Department? Yes No If yes, mo day/yr sample was submitted
Water Well Disinfected? Yes No

5 TYPE OF BLANK CASING USED:
1 Steel 3 RMP (SR) 5 Wrought iron 8 Concrete tile CASING JOINTS: Glued Clamped
 PVC 4 ABS 6 Asbestos-Cement 9 Other (specify below) Welded
7 Fiberglass Eagle-Loc Threaded

Blank casing diameter 5 in. to 432 ft. Dia in. to ft. Dia in. to ft.
Casing height above land surface 18 in. weight lbs/ft. Wall thickness or gauge No. SDR 21

TYPE OF SCREEN OR PERFORATION MATERIAL:
1 Steel 3 Stainless Steel 5 Fiberglass 8 RMP (SR) 10 Asbestos-Cement
2 Brass 4 Galvanized Steel 6 Concrete tile 9 ABS 11 Other (Specify)
12 None used (open hole)

SCREEN OR PERFORATION OPENINGS ARE:
1 Continuous slot 3 Mill slot 5 Gauzed wrapped 8 Saw cut 11 None (open hole)
2 Louvered shutter 4 Key punched 6 Wire wrapped 9 Drilled holes
7 Torch cut 10 Other (specify)

SCREEN-PERFORATED INTERVALS: From 280 ft. to 300 ft. From 320 ft. to 340 ft.
From 360 ft. to 380 ft. From 400 ft. to 420 ft.
GRAVEL PACK INTERVALS: From 25 ft. to 432 ft. From ft. to ft.

6 GROUT MATERIAL: 1 Neat cement 2 Cement grout Bentonite 4 Other
Grout intervals: From 5 ft. to 25 ft. From ft. to ft. From ft. to ft.

What is the nearest source of possible contamination:
1 Septic tank 4 Lateral lines 7 Pit privy 10 Livestock pens 14 Abandoned water well
2 Sewer lines 5 Cess pool 8 Sewage lagoon 11 Fuel storage 15 Oil well/Gas well
3 Watertight sewer lines 6 Seepage pit 9 Feedyard 12 Fertilizer storage 16 Other (specify below)
Direction from well? How many feet? none observed

| FROM | TO | LITHOLOGIC LOG | FROM | TO | PLUGGING INTERVALS |
|------|-----|-------------------------|------|----|--------------------|
| 0 | 20 | Top soil + Fine Sand | | | |
| 20 | 75 | Br + white clay | | | |
| 75 | 80 | med sand | | | |
| 80 | 220 | Br + grey clay | | | |
| 220 | 240 | med sand | | | |
| 240 | 320 | white + Brown clay | | | |
| 320 | 355 | Black + Brown clay | | | |
| 355 | 420 | Sand stone + Blue clay | | | |
| 420 | 460 | Sand stone + white clay | | | |

7 CONTRACTOR'S OR LANDOWNER'S CERTIFICATION: This water well was constructed, (2) reconstructed, or (3) plugged under my jurisdiction and was completed on (mo/day/year) and this record is true to the best of my knowledge and belief. Kansas Water Well Contractor's Licence No 473 This Water Well Record was completed on (mo/day/yr) 8/17/06 under the business name of Tyler Water Well Inc by (signature) Dustin Eyer

INSTRUCTIONS: Use typewriter or ball point pen. PLEASE PRESS HARD and PRINT clearly. Please fill in blanks, underline or circle the correct answer(s). Send two copies to Kansas Department of Health and Environment, Bureau of Water, Geology Section, 1600 SW Jackson St., Suite 421, Topeka, Kansas 66612-1367. Telephone 785-296-5522. Send one to WATER WELL OWNER and retain one for your records. Fee of \$5.00 for each constructed well.