


1 LOCATION OF WATER WELL: Grant County:	Fraction NW $\frac{1}{4}$ NE $\frac{1}{4}$ NW $\frac{1}{4}$	Section Number 34	Township Number 28S	Range Number 37W EW
--	--	-----------------------------	-------------------------------	-------------------------------

Distance and direction from nearest town or city street address of well if located within city?
103 E. Oklahoma, Ulysses, Kansas

2 WATER WELL OWNER: Taylor Food Mart #629 RR #, St. Address, Box #: 1824 Hillandale Road City, State, ZIP Code : Durham, NC 27705	Board of Agriculture, Division of Water Resources Application Number:
--	--

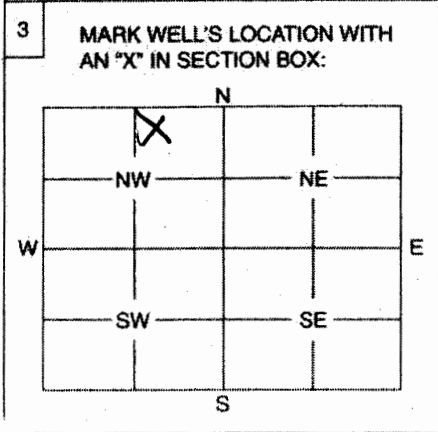

4 DEPTH OF WELL 85 ft. WELL'S STATIC WATER LEVEL 68.89 ft. WELL WAS USED AS: <table style="width:100%; border: none;"> <tr> <td style="width:33%;">1 Domestic</td> <td style="width:33%;">5 Public Water Supply</td> <td style="width:33%;">9 Dewatering</td> </tr> <tr> <td>2 Irrigation</td> <td>6 Oil Field Water Supply</td> <td>10 Monitoring Well</td> </tr> <tr> <td>3 Feedlot</td> <td>7 Domestic (Lawn & Garden)</td> <td>11 Injection Well</td> </tr> <tr> <td>4 Industrial</td> <td>8 Air Conditioning</td> <td>12 Other</td> </tr> </table>	1 Domestic	5 Public Water Supply	9 Dewatering	2 Irrigation	6 Oil Field Water Supply	10 Monitoring Well	3 Feedlot	7 Domestic (Lawn & Garden)	11 Injection Well	4 Industrial	8 Air Conditioning	12 Other
1 Domestic	5 Public Water Supply	9 Dewatering										
2 Irrigation	6 Oil Field Water Supply	10 Monitoring Well										
3 Feedlot	7 Domestic (Lawn & Garden)	11 Injection Well										
4 Industrial	8 Air Conditioning	12 Other										
Was a chemical / bacteriological sample submitted to Department? Yes No X If yes, mo/day/yr sample was submitted												
Water Well Disinfected: Yes No X												

5 TYPE OF BLANK CASING USED: <table style="width:100%; border: none;"> <tr> <td>1 Steel</td> <td>3 RMP (SR)</td> <td>5 Wrought</td> <td>7 Fiberglass</td> <td>9 Other (Specify below)</td> </tr> <tr> <td>2 PVC</td> <td>4 ABS</td> <td>6 Asbestos-Cement</td> <td>8 Concrete Tile</td> <td></td> </tr> </table>	1 Steel	3 RMP (SR)	5 Wrought	7 Fiberglass	9 Other (Specify below)	2 PVC	4 ABS	6 Asbestos-Cement	8 Concrete Tile		Blank casing diameter 2 in. Was casing pulled? Yes X No If yes, how much 3' Casing height above or below land surface in.
1 Steel	3 RMP (SR)	5 Wrought	7 Fiberglass	9 Other (Specify below)							
2 PVC	4 ABS	6 Asbestos-Cement	8 Concrete Tile								

6 GROUT PLUG MATERIAL: 3 Neat cement 2 Cement grout 3 Bentonite 4 Other surface silts/clays Grout Plug Intervals: From 85 ft. to 3 ft. From 3 ft. to 0 ft. From to ft.	What is the nearest source of possible contamination: <table style="width:100%; border: none;"> <tr> <td>1 Septic tank</td> <td>6 Seepage pit</td> <td>11 Fuel storage</td> <td rowspan="5" style="vertical-align: top;">16 Other (specify below) conts. k</td> </tr> <tr> <td>2 Sewer lines</td> <td>7 Pit privy</td> <td>12 Fertilizer storage</td> </tr> <tr> <td>3 Watertight sewer lines</td> <td>8 Sewage lagoon</td> <td>13 Insecticide storage</td> </tr> <tr> <td>4 Lateral lines</td> <td>9 Feedyard</td> <td>14 Abandoned water well</td> </tr> <tr> <td>5 Cess pool</td> <td>10 Livestock pens</td> <td>15 Oil well/Gas well</td> </tr> </table>	1 Septic tank	6 Seepage pit	11 Fuel storage	16 Other (specify below) conts. k	2 Sewer lines	7 Pit privy	12 Fertilizer storage	3 Watertight sewer lines	8 Sewage lagoon	13 Insecticide storage	4 Lateral lines	9 Feedyard	14 Abandoned water well	5 Cess pool	10 Livestock pens	15 Oil well/Gas well
1 Septic tank	6 Seepage pit	11 Fuel storage	16 Other (specify below) conts. k														
2 Sewer lines	7 Pit privy	12 Fertilizer storage															
3 Watertight sewer lines	8 Sewage lagoon	13 Insecticide storage															
4 Lateral lines	9 Feedyard	14 Abandoned water well															
5 Cess pool	10 Livestock pens	15 Oil well/Gas well															
Direction from well? How many feet?																	

FROM	TO	PLUGGING MATERIALS
85	3	Bentonite
3	0	Surface silts/clays

7 CONTRACTOR'S OF LANDOWNER'S CERTIFICATION: This water well was plugged under my jurisdiction and was completed on (mo/day/year) 12/14/07 and this record is true to the best of my knowledge and belief. Kansas Water Well Contractor's License No. 585 This Water Well Record was completed on (mo/day/year) 01/11/08 under the business name of Associated Environmental, Inc. by (signature) B. Johnson	
---	--

INSTRUCTIONS: Use typewriter or ball point pen. Please press firmly and print clearly. Please fill in blanks, underline or circle the correct answers. Send top three copies to Kansas Department of Health and Environment, Bureau of Water, Geology Section, 1000 SW Jackson St., Ste. 420, Topeka, Kansas 66612-1367. Telephone: 785/296-5522. Send one to Water Well Owner and retain one for your records.