

USE TYPEWRITER OR BALL POINT PEN—PRESS FIRMLY, PRINT CLEARLY.


WATER WELL RECORD  
KSA 82a-1201-1215

T R EW sec 1/4 1/4 1/4 No.

Kansas State Dept. Of Health  
(Water Well Contractors)  
Forbes-Bldg. 740  
Topeka, Kansas 66620

1 Location of well: County Grant Township name Lincoln Fraction N W 1/4 Section number 35 Town number T 28 S Range number 37 W

Distance and direction from nearest town or city: E. of city limits 3 Owner of well: Russell Binney  
Street address of well location if in city: in Valley View 2nd Addition. Address: Ulysses, Ks.

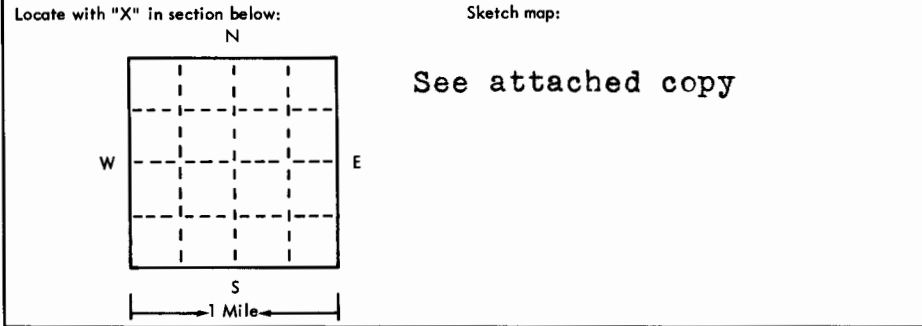

| 2 | Type and color of material         | From | To  |
|---|------------------------------------|------|-----|
|   | Surface & fine sand                | 0    | 15  |
|   | Sand                               | 15   | 60  |
|   | Brown clay                         | 60   | 105 |
|   | Blue clay                          | 105  | 150 |
|   | Brown clay                         | 150  | 210 |
|   | Fine sand                          | 210  | 225 |
|   | Brown clay                         | 225  | 285 |
|   | Yellow chalk, br. clay & Sandstone | 285  | 330 |
|   | Blue shale                         | 330  | 465 |
|   | " " , Dakota & Sandstone           | 465  | 495 |
|   | " " , Sandstone & Cheyenne         | 495  | 525 |
|   | (use a second sheet if needed)     |      |     |

4 Well depth: 520 ft. Date of completion 6-10-1975  
Well diameter 9 7/8 in.

5  Cable tool  Rotary  Driven  Dug  
 Hollow rod  Jetted  Bored  Reverse rotary

6 Use:  Domestic  Public supply  Industry  
 Irrigation  Air conditioning  Commercial  
 Test well

7 Casing: Material stryo Height: above/below  
Threaded  Welded  Surface      in.  
Dia. 5 in. to 520 ft. depth! Weight 320 lbs./ft. wall  
Drive shoe?  Yes  No

8 Screen: Manufacturer Jesse & Lowell  
Type stryo Dia. 5"  
Slot/gauze 11/16 Length       
Set between      ft. and      ft.  
Fittings: Plain 0-460:Perf. 460-520  
Gravel pack  Yes  No Size range of material 1/4-1 1/4

9 Static water level: 130 ft. below land surface Date 6-1-1975

10 Pumping level below land surfaces: NA  
     ft. after      hrs. pumping      g.p.m.  
     ft. after      hrs. pumping      g.p.m.  
Estimated maximum yield      g.p.m.

11 Water sample submitted:  
 Yes  No Date     

12 Well head completion:  
 Pitless adapter  Inches above grade

13 Well grouted?  Yes  No  
 Neat cement  Bentonite        
Depth: From 6 ft. to 20 ft.

14 Nearest source of possible contamination:  
ft. 80' Direction N Type corral  
Well disinfected upon completion?  Yes  No

15 Pump:  Not installed  
Manufacturer's name Gould  
Model number na HP 5 Volts 230  
Length of drop pipe 305 ft. capacity 30 g.p.m.  
Type:  
 Submersible  Turbine  
 Jet  Reciprocating  
 Centrifugal  Other

16 Remarks: elevation

Topography:  
 Hill  
 Slope  
 Upland  
 Valley

17 Water well contractor's certification:  
This well was drilled under my jurisdiction and this report is true to the best of my knowledge and belief.  
Wagner Drilling 253  
Business name License No.  
Address Ulysses, Ks.  
Signed [Signature] Date 6-10-1975  
Authorized representative

Forward the white, blue and pink copies to the Kansas State Dept. Of Health.