

CORRECTION(S) TO WATER WELL RECORD (WWC-5)
(to rectify lacking or incorrect information)

County: Grant

Location listed as:

Section-Township-Range: 21-285-34W

Fraction ($\frac{1}{4}$ $\frac{1}{4}$ $\frac{1}{4}$): NW SW SW

Location changed to:

21-285-37W

SW SW NW

Other changes: Initial statements: _____

Changed to: _____

Comments: _____

verification method: Well address, area road map, and mapping tool & aerial photo on KGS website.

initials: ARD date: 10/15/2008


submitted by: Kansas Geological Survey, Data Resources Library, 1930 Constant Ave., Lawrence, KS 66047-3726
to: Kansas Dept of Health & Environment, Bureau of Water, 1000 SW Jackson, Suite 420, Topeka, KS 66612-1367.

1 LOCATION OF WATER WELL: County: Grant Fraction: NW 1/4 SW 1/4 SW 1/4 Section Number: 21 Township Number: T 28 S Range Number: R 34 E (W)

Distance and direction from nearest town or city street address of well if located within city?
1550 N, Road I Ulysses, KS

2 WATER WELL OWNER: Grant Co. Road Dept
 RR#, St. Address, Box #: 1550 N. Road I
 City, State, ZIP Code: Ulysses, KS 67880
 Board of Agriculture, Division of Water Resources
 Application Number:

3 LOCATE WELL'S LOCATION WITH AN "X" IN SECTION BOX:

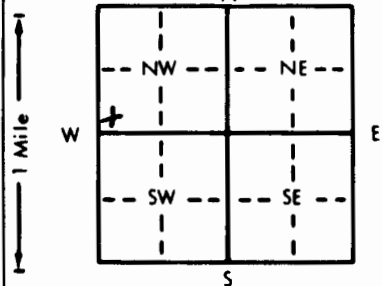

4 DEPTH OF COMPLETED WELL: 59 ft. ELEVATION:
 Depth(s) Groundwater Encountered: 1. 58.5 ft. 2. . ft. 3. . ft.
 WELL'S STATIC WATER LEVEL: 58.5 ft. below land surface measured on mo/day/yr
 Pump test data: Well water was . ft. after . hours pumping . gpm
 Est. Yield . gpm: Well water was . ft. after . hours pumping . gpm
 Bore Hole Diameter: 8 in. to 59 ft., and . in. to . ft.
 WELL WATER TO BE USED AS:
 5 Public water supply 8 Air conditioning 11 Injection well
 1 Domestic 3 Feedlot 6 Oil field water supply 9 Dewatering
 2 Irrigation 4 Industrial 7 Lawn and garden only 10 Monitoring well
 12 Other (Specify below) SB-2 Exploratory borings
 Was a chemical/bacteriological sample submitted to Department? Yes . No ; If yes, mo/day/yr sample was submitted
 Water Well Disinfected? Yes . No

5 TYPE OF BLANK CASING USED:
 1 Steel 3 RMP (SR) 5 Wrought iron 8 Concrete tile CASING JOINTS: Glued . Clamped .
 2 PVC 4 ABS 6 Asbestos-Cement 9 Other (specify below) Welded .
 7 Fiberglass . Threaded .
 Blank casing diameter: Ø in. to . ft., Dia . in. to . ft., Dia . in. to . ft.
 Casing height above land surface: Ø in., weight . lbs./ft. Wall thickness or gauge No. .
 TYPE OF SCREEN OR PERFORATION MATERIAL:
 1 Steel 3 Stainless steel 5 Fiberglass 7 PVC 10 Asbestos-cement
 2 Brass 4 Galvanized steel 6 Concrete tile 8 RMP (SR) 11 Other (specify) 99/NA
 9 ABS 12 None used (open hole)
 SCREEN OR PERFORATION OPENINGS ARE:
 1 Continuous slot 3 Mill slot 5 Gauzed wrapped 8 Saw cut 11 None (open hole)
 2 Louvered shutter 4 Key punched 6 Wire wrapped 9 Drilled holes
 7 Torch cut 10 Other (specify) NA
 SCREEN-PERFORATED INTERVALS: From 99.9 ft. to . ft., From . ft. to . ft.
 From . ft. to . ft., From . ft. to . ft.
 GRAVEL PACK INTERVALS: From . ft. to . ft., From . ft. to . ft.
 From . ft. to . ft., From . ft. to . ft.

6 GROUT MATERIAL: 1 Neat cement 2 Cement grout 3 Bentonite 4 Other .
 Grout intervals: From 59 ft. to 3 ft., From . ft. to . ft., From . ft. to . ft.
 What is the nearest source of possible contamination:
 1 Septic tank 4 Lateral lines 7 Pit privy 10 Livestock pens 14 Abandoned water well
 2 Sewer lines 5 Cess pool 8 Sewage lagoon 11 Fuel storage 15 Oil well/Gas well
 3 Watertight sewer lines 6 Seepage pit 9 Feedyard 12 Fertilizer storage 16 Other (specify below) UST
 13 Insecticide storage
 Direction from well? 30 South How many feet? 30

FROM	TO	LITHOLOGIC LOG	FROM	TO	PLUGGING INTERVALS
0	3.5	silty sand	0	3	surface silt and clay
3.5	8.5	clay	3	59	Cement grout
8.5	13.5	silty clay			
13.5	18.5	Brown silty sand			
18.5	22.5	Reddish brown clayey silty sand			
22.5	28.5	Reddish brown clayey silty sand			
28.5	34.5	Reddish brown clay			
34.5	38.5	Reddish brown clay			
38.5	48.5	silty sand			
48.8	49.5	silty clay			
49.5	58.5	Brown silty sand			
58.5	59	silty clayey sand			
59		silty clay			

7 CONTRACTOR'S OR LANDOWNER'S CERTIFICATION: This water well was (1) constructed, (2) reconstructed, or (3) plugged under my jurisdiction and was completed on (mo/day/year) 11/27/95 and this record is true to the best of my knowledge and belief. Kansas Water Well Contractor's License No. 540 This Water Well Record was completed on (mo/day/yr) 11/25/95 under the business name of Prairie Land Environmental Remediation Inc by (signature) [Signature]