

CORRECTION(S) TO WATER WELL RECORD (WWC-5)  
(to rectify lacking or incorrect information)

County: Grant

Location listed as:

Section-Township-Range: 21-285-34W

Fraction (  $\frac{1}{4}$   $\frac{1}{4}$   $\frac{1}{4}$ ): NW SW SW

Location changed to:

21-285-37W

SW SW NW

Other changes: Initial statements: \_\_\_\_\_

Changed to: \_\_\_\_\_

Comments: \_\_\_\_\_

verification method: well address, area road map, and mapping tool & aerial photo on KGS website.


initials: ARD date: 10/15/2008

1) LOCATION OF WATER WELL: County: Grant Fraction: NW 1/4 SW 1/4 SW 1/4 Section Number: 21 Township Number: T 28 S Range Number: R 34 EW

Distance and direction from nearest town or city street address of well if located within city?  
1550 N. Road I Ulysses Ulysses KS

2) WATER WELL OWNER: Grant County Road Dept Board of Agriculture, Division of Water Resources  
 RR#, St. Address, Box #: 1550 N Road I Application Number:  
 City, State, ZIP Code: Ulysses, KS 67880

3) LOCATE WELL'S LOCATION WITH AN "X" IN SECTION BOX: 4) DEPTH OF COMPLETED WELL: \_\_\_\_\_ ft. ELEVATION: \_\_\_\_\_

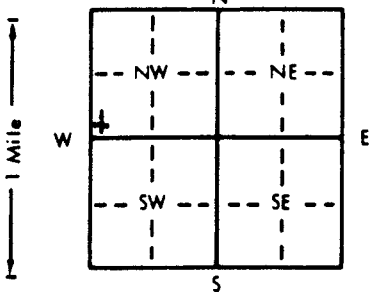

Depth(s) Groundwater Encountered 1. 53.5 ft. 2. \_\_\_\_\_ ft. 3. \_\_\_\_\_ ft.  
 WELL'S STATIC WATER LEVEL \_\_\_\_\_ ft. below land surface measured on mo/day/yr  
 Pump test data: Well water was \_\_\_\_\_ ft. after \_\_\_\_\_ hours pumping \_\_\_\_\_ gpm  
 Est. Yield \_\_\_\_\_ gpm: Well water was \_\_\_\_\_ ft. after \_\_\_\_\_ hours pumping \_\_\_\_\_ gpm  
 Bore Hole Diameter: 8 in. to 55 ft., and \_\_\_\_\_ in. to \_\_\_\_\_ ft.  
 WELL WATER TO BE USED AS: 5 Public water supply 8 Air conditioning 11 Injection well  
 1 Domestic 3 Feedlot 6 Oil field water supply 9 Dewatering  
 2 Irrigation 4 Industrial 7 Lawn and garden only 10 Monitoring well Exploratory Boring SB-4  
 Was a chemical/bacteriological sample submitted to Department? Yes \_\_\_\_\_ No  If yes, mo/day/yr sample was submitted  
 Water Well Disinfected? Yes \_\_\_\_\_ No

5) TYPE OF BLANK CASING USED: 5 Wrought iron 8 Concrete tile CASING JOINTS: Glued \_\_\_\_\_ Clamped \_\_\_\_\_  
 1 Steel 3 RMP (SR) 6 Asbestos-Cement 9 Other (specify below) Welded \_\_\_\_\_  
 2 PVC 4 ABS 7 Fiberglass Threaded \_\_\_\_\_

Blank casing diameter \_\_\_\_\_ in. to \_\_\_\_\_ ft., Dia \_\_\_\_\_ in. to \_\_\_\_\_ ft., Dia \_\_\_\_\_ in. to \_\_\_\_\_ ft.  
 Casing height above land surface \_\_\_\_\_ in., weight \_\_\_\_\_ lbs./ft. Wall thickness or gauge No. \_\_\_\_\_

TYPE OF SCREEN OR PERFORATION MATERIAL: 7 PVC 10 Asbestos-cement  
 1 Steel 3 Stainless steel 5 Fiberglass 8 RMP (SR) 11 Other (specify) \_\_\_\_\_  
 2 Brass 4 Galvanized steel 6 Concrete tile 9 ABS 12 None used (open hole)

SCREEN OR PERFORATION OPENINGS ARE: 5 Gauzed wrapped 8 Saw cut 11 None (open hole)  
 1 Continuous slot 3 Mill slot 6 Wire wrapped 9 Drilled holes  
 2 Louvered shutter 4 Key punched 7 Torch cut 10 Other (specify) \_\_\_\_\_

SCREEN-PERFORATED INTERVALS: From \_\_\_\_\_ ft. to \_\_\_\_\_ ft., From \_\_\_\_\_ ft. to \_\_\_\_\_ ft.  
 From \_\_\_\_\_ ft. to \_\_\_\_\_ ft., From \_\_\_\_\_ ft. to \_\_\_\_\_ ft.  
 GRAVEL PACK INTERVALS: From \_\_\_\_\_ ft. to \_\_\_\_\_ ft., From \_\_\_\_\_ ft. to \_\_\_\_\_ ft.  
 From \_\_\_\_\_ ft. to \_\_\_\_\_ ft., From \_\_\_\_\_ ft. to \_\_\_\_\_ ft.

6) GROUT MATERIAL: 1 Neat cement 2 Cement grout 3 Bentonite 4 Other \_\_\_\_\_  
 Grout Intervals: From \_\_\_\_\_ ft. to \_\_\_\_\_ ft., From \_\_\_\_\_ ft. to \_\_\_\_\_ ft., From \_\_\_\_\_ ft. to \_\_\_\_\_ ft.

What is the nearest source of possible contamination: 10 Livestock pens 14 Abandoned water well  
 1 Septic tank 4 Lateral lines 7 Pit privy 11 Fuel storage 15 Oil well/Gas well  
 2 Sewer lines 5 Cess pool 8 Sewage lagoon 12 Fertilizer storage Other (specify below)  
 3 Watertight sewer lines 6 Seepage pit 9 Feedyard 13 Insecticide storage U.S.T.  
 Direction from well? 38 Northwest Southeast How many feet? 30ft

FROM	TO	LITHOLOGIC LOG	FROM	TO	PLUGGING INTERVALS
<del>0</del>	<del>8.5</del>	<del>silty clay</del>	0	3	Surface silt and clay
<del>8.5</del>	<del>13.5</del>	<del>silty sand</del>	3	55	Cement Grout
<del>13.5</del>	<del>18.5</del>	<del>silty clayey sand</del>			
<del>18.5</del>	<del>33.5</del>	<del>clay silty sand</del>			
<del>33.5</del>	<del>35</del>	<del>Clay</del>			
<del>35</del>	<del>45</del>	<del>silty sand</del>			
<del>45</del>	<del>49.5</del>	<del>silty clay</del>			
<del>49.5</del>	<del>53.5</del>	<del>silty sand</del>			
<del>53.5</del>	<del>54.2</del>	<del>silty sand</del>			
<del>54.2</del>	<del>55</del>	<del>silty clay</del>			

7) CONTRACTOR'S OR LANDOWNER'S CERTIFICATION: This water well was (1) constructed, (2) reconstructed, or (3) plugged under my jurisdiction and was completed on (mo/day/year) 11/29/95 and this record is true to the best of my knowledge and belief. Kansas Water Well Contractor's License No. 540 This Water Well Record was completed on (mo/day/yr) 12/5/96  
 under the business name of Prairie Land Environmental Remediation Inc by (signature) \_\_\_\_\_

OFFICE USE ONLY T H E W S E C 1/4 1/4 1/4