

CORRECTION(S) TO WATER WELL RECORD (WWC-5)

(to rectify lacking or incorrect information)

County: Grant

Location listed as:

Location changed to:

Section-Township-Range: 21-285-34W

21-285-37W

Fraction ( 1/4 1/4 1/4): NW SW SW

SW SW NW

Other changes: Initial statements: \_\_\_\_\_

Changed to: \_\_\_\_\_

Comments: \_\_\_\_\_

verification method: Well address, area road map, and mapping tool & aerial photo on KGS website.

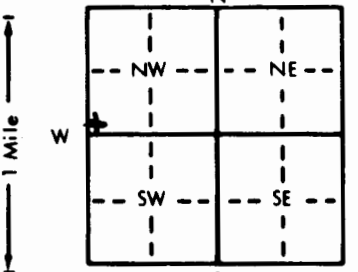
initials: ARD date: 10/15/2008

submitted by: Kansas Geological Survey, Data Resources Library, 1930 Constant Ave., Lawrence, KS 66047-3726  
to: Kansas Dept of Health & Environment, Bureau of Water, 1000 SW Jackson, Suite 420, Topeka, KS 66612-1367.

1 LOCATION OF WATER WELL: County: Grant Fraction: NW 1/4 SW 1/4 SW 1/4 Section Number: 21 Township Number: T 28 S Range Number: R 34 EW

Distance and direction from nearest town or city street address of well if located within city?  
1550 N Rd I Ulysses, KS

2 WATER WELL OWNER: Grant County Road Dept  
 RR#, St. Address, Box #: 1550 Rd I Board of Agriculture, Division of Water Resources  
 City, State, ZIP Code: Ulysses, KS 67880 Application Number:

3 LOCATE WELL'S LOCATION WITH AN "X" IN SECTION BOX:  


4 DEPTH OF COMPLETED WELL: 59.20 ft. ELEVATION:  
 Depth(s) Groundwater Encountered: 1.49.8 ft. 2. . . . . ft. 3. . . . . ft.  
 WELL'S STATIC WATER LEVEL: 48.62 ft. below land surface measured on mo/day/yr 11/5/96  
 Pump test data: Well water was . . . . . ft. after . . . . . hours pumping . . . . . gpm  
 Est. Yield . . . . . gpm: Well water was . . . . . ft. after . . . . . hours pumping . . . . . gpm  
 Bore Hole Diameter: 8 in. to 59.20 ft., and . . . . . in. to . . . . . ft.  
 WELL WATER TO BE USED AS: 5 Public water supply 8 Air conditioning 11 Injection well  
 1 Domestic 3 Feedlot 6 Oil field water supply 9 Dewatering 12 Other (Specify below)  
 2 Irrigation 4 Industrial 7 Lawn and garden only 0 Monitoring well SB-4 mw-4  
 Was a chemical/bacteriological sample submitted to Department? Yes. . . . . No. ; if yes, mo/day/yr sample was sub-  
 mitted Water Well Disinfected? Yes No

5 TYPE OF BLANK CASING USED: 5 Wrought iron 8 Concrete tile CASING JOINTS: Glued . . . . . Clamped . . . . .  
 1 Steel 3 RMP (SR) 6 Asbestos-Cement 9 Other (specify below) Welded . . . . .  
2 PVC 4 ABS 7 Fiberglass Threaded   
 Blank casing diameter: 2 in. to 39.20 ft., Dia. . . . . in. to . . . . . ft., Dia. . . . . in. to . . . . . ft.  
 Casing height above land surface: 0.0 in., weight . . . . . lbs./ft. Wall thickness or gauge No. Sch 40  
 TYPE OF SCREEN OR PERFORATION MATERIAL: 7 PVC 10 Asbestos-cement  
 1 Steel 3 Stainless steel 5 Fiberglass 8 RMP (SR) 11 Other (specify) . . . . .  
 2 Brass 4 Galvanized steel 6 Concrete tile 9 ABS 12 None used (open hole)  
 SCREEN OR PERFORATION OPENINGS ARE: 5 Gauzed wrapped 8 Saw cut 11 None (open hole)  
 1 Continuous slot 3 Mill slot 6 Wire wrapped 9 Drilled holes  
 2 Louvered shutter 4 Key punched 7 Torch cut 10 Other (specify) . . . . .  
 SCREEN-PERFORATED INTERVALS: From: 39.20 ft. to 59.20 ft., From . . . . . ft. to . . . . . ft.  
 From: 8 ft. to . . . . . ft., From . . . . . ft. to . . . . . ft.  
 GRAVEL PACK INTERVALS: From: 38 ft. to 59.20 ft., From . . . . . ft. to . . . . . ft.  
 From . . . . . ft. to . . . . . ft., From . . . . . ft. to . . . . . ft.

6 GROUT MATERIAL: 1 Neat cement 2 Cement grout 3 Bentonite 4 Other . . . . .  
 Grout Intervals: From: 0 ft. to 36 ft., From: 36 ft. to 38 ft., From . . . . . ft. to . . . . . ft.  
 What is the nearest source of possible contamination: 10 Livestock pens 14 Abandoned water well  
 1 Septic tank 4 Lateral lines 7 Pit privy 11 Fuel storage 15 Oil well/Gas well  
 2 Sewer lines 5 Cess pool 8 Sewage lagoon 12 Fertilizer storage 16 Other (specify below)  
 3 Watertight sewer lines 6 Seepage pit 9 Feedyard 13 Insecticide storage UST  
 Direction from well? Northwest Southeast How many feet? 120

FROM	TO	LITHOLOGIC LOG	FROM	TO	PLUGGING INTERVALS
0	5.0	silty clay			
5	13.5	silty sand			
13.5	18.5	clayey silt			
18.5	33.5	silty sand			
33.5	35	clay			
35	48.5	silty sand			
48.5	49.5	silty clay			
49.5		silty sand			

7 CONTRACTOR'S OR LANDOWNER'S CERTIFICATION: This water well was 1 constructed, (2) reconstructed, or (3) plugged under my jurisdiction and was completed on (mo/day/year) 12/5/95 and this record is true to the best of my knowledge and belief. Kansas Water Well Contractor's License No. 540 This Water Well Record was completed on (mo/day/yr) 11/5/96 under the business name of Prairie Land Environmental Remediation Inc by (signature) [Signature]