


1 LOCATION OF WATER WELL:	Fraction	Section Number	Township Number	Range Number
County: Grant	NE ¼ SE ¼ SW ¼	27	T 28 S	R 37 EW

Distance and direction from nearest town or city street address of well if located within city?
204 S. Missouri, Ulysses

2 WATER WELL OWNER: **Dowell**
 RR#, St. Address, Box # : **300 Schlumberger Dr.** Board of Agriculture, Division of Water Resources
 City, State, ZIP Code : **Sugar Land, Texas 77478** Application Number:

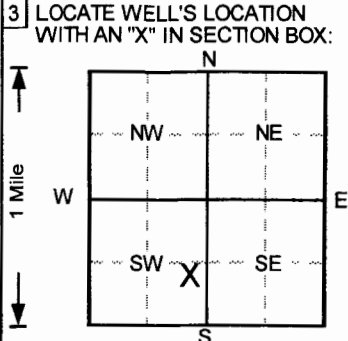

4 DEPTH OF COMPLETED WELL: **70** ft. ELEVATION: _____
 Depth(s) Groundwater Encountered 1. _____ ft. 2. _____ ft. 3. _____ ft.
 WELL'S STATIC WATER LEVEL _____ ft. below land surface measured on mo/day/yr
 Pump test data: Well water was **NA** ft. after _____ hours pumping _____ gpm
 Est. Yield **NA** gpm: Well water was _____ ft. after _____ hours pumping _____ gpm
 Bore Hole Diameter **8** in. to **72** ft., and _____ in. to _____ ft.
 WELL WATER TO BE USED AS: 5 Public water supply 8 Air conditioning 11 Injection well
 1 Domestic 3 Feedlot 6 Oil field water supply 9 Dewatering 12 Other (Specify below)
 2 Irrigation 4 Industrial 7 Lawn and garden only **10** Monitoring well
 Was a chemical/bacteriological sample submitted to Department? Yes _____ No ; If yes, mo/day/yr sample was submitted
 Water Well Disinfected? Yes _____ No

5 TYPE OF BLANK CASING USED:

1 Steel	3 RMP (SR)	5 Wrought iron	8 Concrete tile	CASING JOINTS: Glued _____ Clamped _____
2 PVC	4 ABS	6 Asbestos-Cement	9 Other (specify below)	Welded _____
Blank casing diameter 2 in. to 60 ft., Dia _____ in. to _____ ft.	7 Fiberglass			Threaded. <input checked="" type="checkbox"/>
Casing height above land surface 0 in., weight _____ lbs./ft. Wall thickness or gauge No. Sch. 40				

TYPE OF SCREEN OR PERFORATION MATERIAL

1 Steel	3 Stainless steel	5 Fiberglass	7 PVC	10 Asbestos-cement
2 Brass	4 Galvanized steel	6 Concrete tile	8 RMP (SR)	11 Other (specify) _____
			9 ABS	12 None used (open hole)

SCREEN OR PERFORATION OPENINGS ARE:

1 Continuous slot	3 Mill slot	5 Gauzed wrapped	8 Saw cut	11 None (open hole)
2 Louvered shutter	4 Key punched	6 Wire wrapped	9 Drilled holes	
		7 Torch cut	10 Other (specify) _____	

SCREEN-PERFORATED INTERVALS: From **60** ft. to **70** ft., From _____ ft. to _____ ft.
 From _____ ft. to _____ ft., From _____ ft. to _____ ft.

GRAVEL PACK INTERVALS: From **56** ft. to **72** ft., From _____ ft. to _____ ft.
 From _____ ft. to _____ ft., From _____ ft. to _____ ft.

6 GROUT MATERIAL: 1 Neat cement **2** Cement grout **3** Bentonite 4 Other _____
 Grout Intervals: From **0** ft. to **1** ft., From **1** ft. to **56** ft., From _____ ft. to _____ ft.

What is the nearest source of possible contamination:

1 Septic tank	4 Lateral lines	7 Pit privy	10 Livestock pens	14 Abandoned water well
2 Sewer lines	5 Cess pool	8 Sewage lagoon	11 Fuel storage	15 Oil well/Gas well
3 Watertight sewer lines	6 Seepage pit	9 Feedyard	12 Fertilizer storage	16 Other (specify below) _____
			13 Insecticide storage	

Direction from well? _____ How many feet? _____

FROM	TO	LITHOLOGIC LOG	FROM	TO	PLUGGING INTERVALS
0	0.5	Concrete,			
0.5	1	Sand,			
1	4	Silt, sl. sandy, clayey, Lt. Brown			
4	23	Sand (vf), silty, Brown			
23	26	Sand (vf), silty, clayey, Lt. Brown			
26	36	Sand (vf), silty, Brown to Lt. Brown			
36	39	Sand (vf), silty, clayey, Lt. Brown			
39	45	Sand (vf), silty, Brown			
45	50	Sand (vf), silty, clayey, Brown			
50	53	Silt, sl. sandy (vf), Brown			
53	58	Sand (vf), silty, Brown			
58	61	Silt, Lt. Gray Brown			
61	64	Sand (vf-m), V. Lt. Brown			MW13
64	70	Sand (vf-c), silty, Brown			
70	72	Clay, Brown			

7 CONTRACTOR'S OR LANDOWNER'S CERTIFICATION: This water well was **(1)** constructed, (2) reconstructed, or (3) plugged under my jurisdiction and was completed on (mo/day/year) **1/21/2009** and this record is true to the best of my knowledge and belief.
 Kansas Water Well Contractor's License No. **527**. This Water Well Record was completed on (mo/day/yr) **2/6/2009**
 under the business name of **GeoCore, Inc.** by (signature) *[Signature]*