

WATER WELL RECORD Form WWC-5 KSA 82a-1212


1 LOCATION OF WATER WELL: Fraction Section Number Township Number Range Number
 COUNTY: GRANT NE 1/4 NE 1/4 NE 1/4 24 T 28 S R 31 W

DEL
5/17/2010

Distance and direction from nearest town or city street address of well if located within city?
 FROM ULYSSES - 3 MILES EAST ON 160 HIGHWAY 3 1/2 SOUTH

2 WATER WELL OWNER: CORSER, VAN Board of Agriculture, Division of Water Resources
 RR#, St. Address, Box #: 5485 S. RD. M Application Number:
 City, State, ZIP code: ULYSSES, KS 67880-

3 LOCATE WELL'S LOCATION WITH AN "X" IN SECTION BOX:

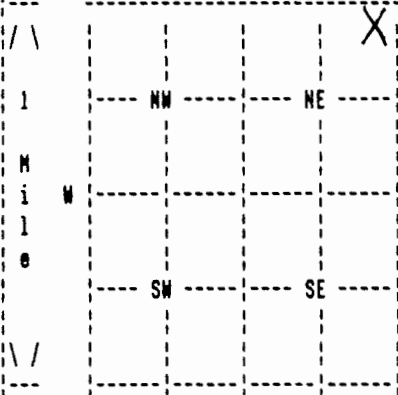

4 DEPTH OF COMPLETED WELL 525 ELEVATION: 0
 Depth(s) Groundwater Encountered 1. 0 ft. 2. 0 ft. 3. 0 ft.

WELL'S STATIC WATER LEVEL 315 ft. below land surface measured on mo/day/yr 07/20/09
 Pump test data: Well water was 0 ft. after 0 hours pumping 0 gpm

Estimated Yield 40 gpm: Well water was 0 ft. after 0 hours pumping 0 gpm

Bore Hole Diameter 10 in. to 525 ft., and in. to 0 ft.

WELL WATER TO BE USED AS: DOMESTIC

Was a chemical/bacteriological sample submitted to department? No ;
 If yes, mo/day/yr sample was submitted Water well disinfected? Yes

5 TYPE OF BLANK CASING USED: CERTA LOC CASIN CASING JOINTS: CERTA-LOC
 Blank casing diameter 5 in. to 525 ft., Dia in. to 0 ft., Dia in. to 0 ft.
 Casing height above land surface 12 in., weight 200 lbs/ft. Wall thickness or gauge No. 17
 TYPE OF SCREEN OR PERFORATION MATERIAL: PVC
 SCREEN OR PERFORATION OPENINGS ARE: SAW CUT

SCREEN PERFORATED INTERVALS: From 340 ft. to 400 ft., From 0 ft. to 0 ft.
 From 460 ft. to 520 ft., From 0 ft. to 0 ft.
 GRAVEL PACK INTERVALS: From 30 ft. to 525 ft., From 0 ft. to 0 ft.
 From 0 ft. to 0 ft., From 0 ft. to 0 ft.

6 GROUT MATERIAL BENTONITE
 Grout Intervals: From 5 ft. to 30 ft., From 0 ft. to 0 ft., From 0 ft. to 0 ft.
 What is the nearest source of possible contamination: NONE
 Direction from well? How many feet? 0

FROM	TO	LITHOLOGIC LOG	FROM	TO	PLUGGING INTERVALS
0	20	01 TOPSOIL 05 CLAY 32 TAN CLAY			
20	180	32 TAN CLAY			
80	160	32 TAN CLAY			
160	180	32 TAN CLAY 16 GRAY CLAY 36 BLUE CLAY			
180	200	36 BLUE CLAY			
200	250	32 TAN CLAY			
250	260	10 FINE-MEDSAND			
260	310	32 TAN CLAY			
280	320	02 FINE SAND 17 CLAY LAYERS			
310	350	32 TAN CLAY 02 FINE SAND 19 LAYERS			

7 CONTRACTOR'S OR LANDOWNER'S CERTIFICATION: This water well was Constructed under my jurisdiction and was completed on (mo/day/year) 07/22/09 and this record is true to the best of my knowledge and belief. Kansas Water Well Contractor's License No. 179 This Water Well Record was completed on (mo/day/yr) 08/21/09 under the business name of JOE'S WELL SERVICE, INC. by (signature) Judith Cuit

(Continued)

WATER WELL RECORD Form WWC-5 KSA 82a-1212

1 LOCATION OF WATER WELL:	Fraction	Section Number	Township Number	Range Number
COUNTY: GRANT	NE 1/4 NE 1/4 NE 1/4	24	T 37 S	R 28 W

2 WATER WELL OWNER:	CORSER, VAN	Board of Agriculture, Division of Water Resources
RR#, St. Address, Box # :	5485 S. RD. M	Application Number:
City, State, ZIP code :	ULYSSES, KS 67880-	

FROM	TO	LITHOLOGIC LOG
350	400	37 FIN-COAR SAN 06 SMALL GRAVEL
400	420	26 RED CLAY 32 TAN CLAY
420	460	32 TAN CLAY
460	480	32 TAN CLAY 24 THINROCLAYER
480	500	32 TAN CLAY 24 THINROCLAYER 29 SANDSTONE
500	550	29 SANDSTONE
550	560	27 ROCK 26 RED CLAY

7 CONTRACTOR'S OR LANDOWNER'S CERTIFICATION: This water well was Constructed under my jurisdiction and was completed on (mo/day/year) 07/22/09 and this record is true to the best of my knowledge and belief. Kansas Water Well Contractor's License No. 179 This Water Well Record was completed on (mo/day/yr) 08/21/09 under the business name of JOE'S WELL SERVICE, INC. by (signature) *Justie Cook*