


WATER WELL RECORD Form WWC-5 KSA 82a-1212

1 LOCATION OF WATER WELL: Fraction Section Number Township Number Range Number
 COUNTY: GRANT NE 1/4 NE 1/4 NE 1/4 24 T 28 S R 37 W

Distance and direction from nearest town or city street address of well if located within city?
 FROM ULYSSES - 3 MILES EAST ON 160 HIGHWAY 3 1/2 SOUTH

2 WATER WELL OWNER: CORSER, VAN Board of Agriculture, Division of Water Resources
 RR#, St. Address, Box #: 5485 S. RD. M Application Number:
 City, State, ZIP code: ULYSSES, KS 67880-

3 LOCATE WELL'S LOCATION WITH AN "X" IN SECTION BOX:

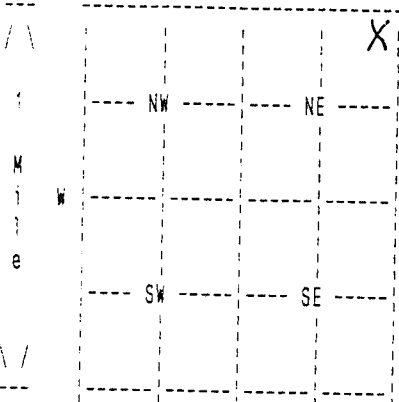

4 DEPTH OF COMPLETED WELL 513 ELEVATION: 0
 Depth(s) Groundwater Encountered 1. 0 ft. 2. 0 ft. 3. 0 ft.

WELL'S STATIC WATER LEVEL 318 ft. below land surface measured on mo/day/yr 07/18/08
 Pump test data: Well water was 0 ft. after 0 hours pumping 0 gpm

Estimated Yield 40 gpm: Well water was 0 ft. after 0 hours pumping 0 gpm

Bore Hole Diameter 10 in. to 513 ft., and in. to 0 ft.

WELL WATER TO BE USED AS: DOMESTIC

Was a chemical/bacteriological sample submitted to department? No ;
 If yes, mo/day/yr sample was submitted Water well disinfected? Yes

5 TYPE OF BLANK CASING USED: CERTA LOC CASIN CASING JOINTS: CERTA-LOC
 Blank casing diameter 5 in. to 513 ft., Dia in. to 0 ft., Dia in. to 0 ft.
 Casing height above land surface 12 in., weight 200 lbs/ft. Wall thickness or gauge No. 17
 TYPE OF SCREEN OR PERFORATION MATERIAL: PVC
 SCREEN OR PERFORATION OPENINGS ARE: SAW CUT

SCREEN PERFORATED INTERVALS: From 348 ft. to 408 ft., From 0 ft. to 0 ft.
 From 448 ft. to 508 ft., From 0 ft. to 0 ft.
 GRAVEL PACK INTERVALS: From 30 ft. to 513 ft., From 0 ft. to 0 ft.
 From 0 ft. to 0 ft., From 0 ft. to 0 ft.

6 GROUT MATERIAL BENTONITE
 Grout Intervals: From 6 ft. to 30 ft., From 0 ft. to 0 ft., From 0 ft. to 0 ft.
 What is the nearest source of possible contamination: NONE
 Direction from well? How many feet? 0

FROM	TO	LITHOLOGIC LOG	FROM	TO	PLUGGING INTERVALS
0	20	01 TOPSOIL 05 CLAY 02 FINE SAND	0	60	grant plugged w/ pump + pipe Well caved in redilled 7-20-09
20	60	32 TAN CLAY	60	-	
60	80	32 TAN CLAY 10 FINE-MEDSAND 05 CLAY			
80	160	32 TAN CLAY			
160	180	32 TAN CLAY 16 GRAY CLAY 36 BLUE CLAY			
180	200	36 BLUE CLAY 16 GRAY CLAY 32 TAN CLAY			
200	250	32 TAN CLAY			
250	260	37 FIN-COAR SAN 05 SMALL GRAVEL			
260	280	32 TAN CLAY 02 FINE SAND 19 LAYERS			
280	320	02 FINE SAND 17 CLAY LAYERS			

7 CONTRACTOR'S OR LANDOWNER'S CERTIFICATION: This water well was Constructed under my jurisdiction and was completed on (mo/day/year) 07/20/08 and this record is true to the best of my knowledge and belief. Kansas Water Well Contractor's License No. 179 This Water Well Record was completed on (mo/day/yr) 08/08/08 under the business name of JOE'S WELL SERVICE, INC. by (signature) Judith Cribb

(Continued)

WATER WELL RECORD Form WWC-5 KSA 82a-1212

1 LOCATION OF WATER WELL:	Fraction	Section Number	Township Number	Range Number
COUNTY: GRANT	NE 1/4 NE 1/4 NE 1/4	24	T 37 S	R 28 W

2 WATER WELL OWNER: CORSER, VAN
 RR#, St. Address, Box #: 5485 S. RD. M
 City, State, ZIP code : ULYSSES, KS 67880-

Board of Agriculture, Division of Water Resources
 Application Number:

FROM	TO	LITHOLOGIC LOG
320	390	37 FIN-COAR SAN 06 SMALL GRAVEL
390	400	08 ROCK LAYERS 26 RED CLAY 05 CLAY
400	460	26 RED CLAY 29 SANDSTONE
460	520	29 SANDSTONE

reduced

7 CONTRACTOR'S OR LANDOWNER'S CERTIFICATION: This water well was Constructed under my jurisdiction and was completed on (mo/day/year) 07/20/08 and this record is true to the best of my knowledge and belief. Kansas Water Well Contractor's License No. 179 This Water Well Record was completed on (mo/day/yr) 08/08/08 under the business name of JOE'S WELL SERVICE, INC. by (signature) *Justin Cook*