

WATER WELL RECORD Form WWC-5


Original Record Correction Change in Well Use

Division of Water Resources App. No.

Well ID

1 LOCATION OF WATER WELL: Fraction $\frac{1}{4}$ SW $\frac{1}{4}$ SW $\frac{1}{4}$ SE $\frac{1}{4}$ Section Number **24** Township Number T **28** S Range Number R **37** E **W**
 County: **Grant**

2 WELL OWNER: Last Name: **Maldonado** First: **Orlando** Street or Rural Address where well is located (if unknown, distance and direction from nearest town or intersection): If at owner's address, check here:
 Business: **817 N. Ulysses Parkway**
 Address: **Ulysses** State: **KS** ZIP: **67880** **2 miles East of Ulysses**
 City: **Ulysses**

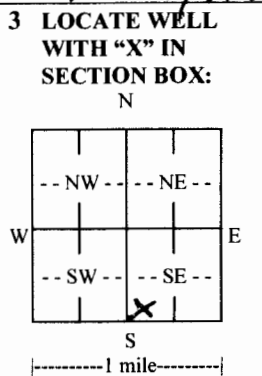

4 DEPTH OF COMPLETED WELL: **495** ft.
 Depth(s) Groundwater Encountered: 1) ft.
 2) ft. 3) ft., or Dry Well
 WELL'S STATIC WATER LEVEL: **270** ft.
 below land surface, measured on (mo-day-yr)
 above land surface, measured on (mo-day-yr)
 Pump test data: Well water was ft.
 after hours pumping gpm
 Well water was ft.
 after hours pumping gpm
 Estimated Yield: gpm
 Bore Hole Diameter: **7.78** in. to ft. and
 in. to ft.

5 Latitude: (decimal degrees)
Longitude: (decimal degrees)
 Datum: WGS 84 NAD 83 NAD 27
Source for Latitude/Longitude:
 GPS (unit make/model:)
 (WAAS enabled? Yes No)
 Land Survey Topographic Map
 Online Mapper:
6 Elevation: ft. Ground Level TOC
Source: Land Survey GPS Topographic Map
 Other

7 WELL WATER TO BE USED AS:

1. Domestic: Household Lawn & Garden Livestock
 Irrigation
 Feedlot
 Industrial

2. Public Water Supply: well ID
 Dewatering: how many wells?
 Aquifer Recharge: well ID
 Monitoring: well ID
 Environmental Remediation: well ID
 Air Sparge Soil Vapor Extraction
 Recovery Injection

10. Oil Field Water Supply: lease
 11. Test Hole: well ID
 Cased Uncased Geotechnical
 12. Geothermal: how many bores?
 a) Closed Loop Horizontal Vertical
 b) Open Loop Surface Discharge Inj. of Water
 13. Other (specify):

Was a chemical/bacteriological sample submitted to KDHE? Yes No If yes, date sample was submitted:
 Water well disinfected? Yes No

8 TYPE OF CASING USED: Steel PVC Other CASING JOINTS: Glued Clamped Welded Threaded
 Casing diameter **5** in. to **4.95** ft., Diameter in. to ft., Diameter in. to ft.
 Casing height above land surface **12** in. Weight lbs./ft. Wall thickness or gauge No. **30K-21**
TYPE OF SCREEN OR PERFORATION MATERIAL:
 Steel Stainless Steel Fiberglass PVC Other (Specify)
 Brass Galvanized Steel Concrete tile None used (open hole)
SCREEN OR PERFORATION OPENINGS ARE:
 Continuous Slot Mill Slot Gauze Wrapped Torch Cut Drilled Holes Other (Specify)
 Louvered Shutter Key Punched Wire Wrapped Saw Cut None (Open Hole)
SCREEN-PERFORATED INTERVALS: From **455** ft. to **495** ft., From ft. to ft., From ft. to ft.
GRAVEL PACK INTERVALS: From **220** ft. to **495** ft., From ft. to ft., From ft. to ft.

9 GROUT MATERIAL: Neat cement Cement grout Bentonite Other
 Grout Intervals: From **5** ft. to **25** ft., From **215** ft. to **270** ft., From ft. to ft.

Nearest source of possible contamination:
 Septic Tank Lateral Lines Pit Privy Livestock Pens Insecticide Storage
 Sewer Lines Cess Pool Sewage Lagoon Fuel Storage Abandoned Water Well
 Watertight Sewer Lines Seepage Pit Feedyard Fertilizer Storage Oil Well/Gas Well
 Other (Specify)
 Direction from well? **North** Distance from well? **600** ft.

10 FROM	TO	LITHOLOGIC LOG	FROM	TO	LITHO. LOG (cont.) or PLUGGING INTERVALS
0	2	Sandy top soil	730	757	Clay & Sandstone
2	50	Caliche Clay	757	770	Willow Clay
50	75	Gray Caliche Clay	770	420	Shale
75	90	Gray & Yellow Clay	420	470	Gray Clay & Sandstone layers
90	150	Gray & Brown Clay	470	498	Sand
150	190	Blue clay	498	507	Sharp Hard
190	270	Tan Clay w/ Sand streaks	Notes:		
270	255	Med Sand w/ clay streaks			
255	370	Sand & Tan Clay 50/50			

11 CONTRACTOR'S OR LANDOWNER'S CERTIFICATION: This water well was constructed, reconstructed, or plugged under my jurisdiction and was completed on (mo-day-year) **6-22-15** and this record is true to the best of my knowledge and belief.
 Kansas Water Well Contractor's License No. **805** This Water Well Record was completed on (mo-day-year) **7-14-15**
 under the business name of **Southwest Windmill**