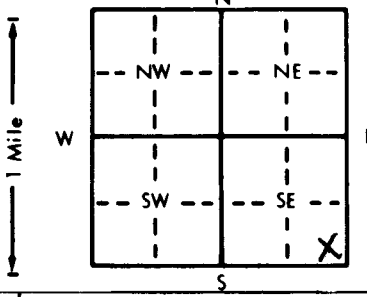


LOCATION OF WATER WELL: Fraction SE 1/4 SE 1/4 SE 1/4 Section Number 17 Township Number T 28 S Range Number R 3 E/W
 County: Grant
 Distance and direction from nearest town or city street address of well if located within city?

2 WATER WELL OWNER: Brown Dupree Oil Co., Inc.
 RR#, St. Address, Box #: 416 S. Colo. Board of Agriculture, Division of Water Resources
 City, State, ZIP Code: Ulysses, Ks. 67880 MW# 4 Application Number:

3 LOCATE WELL'S LOCATION WITH AN "X" IN SECTION BOX:

 4 DEPTH OF COMPLETED WELL: 310 ft. ELEVATION:
 Depth(s) Groundwater Encountered 1. ft. 2. ft. 3. ft.
 WELL'S STATIC WATER LEVEL: 236.18 ft. below land surface measured on mo/day/yr
 Pump test data: Well water was ft. after hours pumping gpm
 Est. Yield gpm: Well water was ft. after hours pumping gpm
 Bore Hole Diameter: 8 in. to 310 ft., and in. to ft.
 WELL WATER TO BE USED AS:
 5 Public water supply 8 Air conditioning 11 Injection well
 1 Domestic 3 Feedlot 6 Oil field water supply 9 Dewatering 12 Other (Specify below)
 2 Irrigation 4 Industrial 7 Lawn and garden only 10 Monitoring well
 Was a chemical/bacteriological sample submitted to Department? Yes.....No...X.....; If yes, mo/day/yr sample was sub-
 mitted Water Well Disinfected? Yes No X

5 TYPE OF BLANK CASING USED:
 1 Steel 3 RMP (SR) 5 Wrought iron 8 Concrete tile CASING JOINTS: Glued Clamped
 2 PVC 4 ABS 6 Asbestos-Cement 9 Other (specify below) Welded
 7 Fiberglass Threaded...X.....
 Blank casing diameter: 4 in. to 280 ft., Dia. in. to ft., Dia. in. to ft.
 Casing height above land surface: 0 in., weight 2.071 lbs./ft. Wall thickness or gauge No. 237
 TYPE OF SCREEN OR PERFORATION MATERIAL:
 1 Steel 3 Stainless steel 5 Fiberglass 7 PVC 10 Asbestos-cement
 2 Brass 4 Galvanized steel 6 Concrete tile 8 RMP (SR) 11 Other (specify)
 9 ABS 12 None used (open hole)
 SCREEN OR PERFORATION OPENINGS ARE:
 1 Continuous slot 3 Mill slot 5 Gauzed wrapped 8 Saw cut 11 None (open hole)
 2 Louvered shutter 4 Key punched 6 Wire wrapped 9 Drilled holes
 7 Torch cut 10 Other (specify)
 SCREEN-PERFORATED INTERVALS: From 280 ft. to 310 ft., From ft. to ft.
 From ft. to ft., From ft. to ft.
 GRAVEL PACK INTERVALS: From 275 ft. to 310 ft., From ft. to ft.
 From ft. to ft., From ft. to ft.

6 GROUT MATERIAL: 1 Neat cement 2 Cement grout 3 Bentonite 4 Other
 Grout Intervals: From 0 ft. to 267 ft., From 267 ft. to 275 ft., From ft. to ft.
 What is the nearest source of possible contamination:
 1 Septic tank 4 Lateral lines 7 Pit privy 10 Livestock pens 14 Abandoned water well
 2 Sewer lines 5 Cess pool 8 Sewage lagoon 11 Fuel storage 15 Oil well/Gas well
 3 Watertight sewer lines 6 Seepage pit 9 Feedyard 12 Fertilizer storage 16 Other (specify below)
 13 Insecticide storage Removed Fuel Storage
 Direction from well? How many feet?

FROM	TO	LITHOLOGIC LOG	FROM	TO	PLUGGING INTERVALS
0	2	Surface	210	230	Sandy Clay w/Some Fine Sand
2	20	Loess	230	243	Sandy Clay w/Some Sand
20	25	Fine Sand	243	250	Med. Sand w/Some Clay
25	40	Sandy Clay	250	251	Hard Caliche
40	50	Clay	251	254	Caliche w/Clay & Sand Strks.
50	62	Med. Sand w/Clay Strks.	254	260	Med. Sand w/Clay & Caliche
62	80	Sandy Clay w/Caliche Strks.	260	280	Sandy Clay w/Caliche & Sand
80	100	Sandy Clay w/some Caliche	280	290	Fine Sand w/Clay&Caliche St.
100	115	Sandy Clay	290	300	Sandy Clay w/Shale Strks.
115	120	Shale	300	306	Sticky Clay
120	130	Shale w/Clay Strks.	306	310	Sand
130	145	Sticky Clay w/Some Shale Str.			
145	190	Sandy Clay w/Caliche & Some Shale			
190	200	Sandy Clay w/Some Caliche			
200	210	Sandy Clay w/Some Caliche & Fine Sand			

7 CONTRACTOR'S OR LANDOWNER'S CERTIFICATION: This water well was (1) constructed, (2) reconstructed, or (3) plugged under my jurisdiction and was completed on (mo/day/year) 8-2-94 and this record is true to the best of my knowledge and belief. Kansas Water Well Contractor's License No. 554 This Water Well Record was completed on (mo/day/yr) 9-15-94 under the business name of Woofter Pump & Well, Inc. by (signature) Jay C. Woofter

INSTRUCTIONS: Use typewriter or ball point pen. PLEASE PRESS FIRMLY and PRINT clearly. Please fill in blanks, underline or circle the correct answers. Send up three copies to Kansas Department of Health and Environment, Bureau of Water, Topeka, Kansas 66620-0001. Telephone: 913-296-5545. Send one to WATER WELL OWNER and retain one for your records.