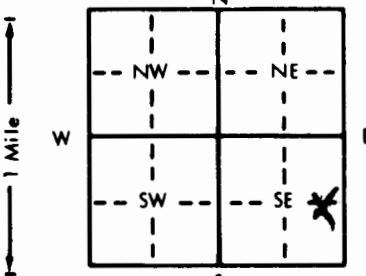


1 LOCATION OF WATER WELL: Fraction 1/4 C/E 1/4 SE 1/4 Section Number 17 Township Number T 28 S Range Number R 37W E/W
 County: GRANT
 Distance and direction from nearest town or city street address of well if located within city?

2 WATER WELL OWNER: MINTER-WISON DRLG.
 RR#, St. Address, Box # : W HWY. 50 Board of Agriculture, Division of Water Resources
 City, State, ZIP Code : GARDEN CITY, KS 67846 Application Number:

3 LOCATE WELL'S LOCATION WITH AN "X" IN SECTION BOX:

 4 DEPTH OF COMPLETED WELL: 380 ft. ELEVATION:
 Depth(s) Groundwater Encountered 1. 240 ft. 2. ft. 3. ft.
 WELL'S STATIC WATER LEVEL 240 ft. below land surface measured on mo/day/yr 9-22-94
 Pump test data: Well water was 260 ft. after 1 hours pumping 75 gpm
 Est. Yield 75 gpm: Well water was ft. after hours pumping gpm
 Bore Hole Diameter 9 1/2 in. to 380 ft., and in. to ft.
 WELL WATER TO BE USED AS:
 1 Domestic 3 Feedlot 6 Oil field water supply 9 Dewatering 12 Other (Specify below)
 2 Irrigation 4 Industrial 7 Lawn and garden only 10 Monitoring well
 Was a chemical/bacteriological sample submitted to Department? Yes No X; If yes, mo/day/yr sample was submitted
 Water Well Disinfected? Yes X No

5 TYPE OF BLANK CASING USED:
 1 Steel 3 RMP (SR) 5 Wrought iron 8 Concrete tile CASING JOINTS: Glued X Clamped
 2 PVC 4 ABS 6 Asbestos-Cement 9 Other (specify below) Welded
 7 Fiberglass Threaded
 Blank casing diameter 5 in. to 380 ft., Dia. in. to ft., Dia. in. to ft.
 Casing height above land surface 24 in., weight 2,902 lbs./ft. Wall thickness or gauge No. 265 SDR 21
 TYPE OF SCREEN OR PERFORATION MATERIAL:
 1 Steel 3 Stainless steel 5 Fiberglass 7 PVC 10 Asbestos-cement
 2 Brass 4 Galvanized steel 6 Concrete tile 9 ABS 11 Other (specify)
 12 None used (open hole)
 SCREEN OR PERFORATION OPENINGS ARE:
 1 Continuous slot 3 Mill slot 5 Gauzed wrapped 8 Saw cut 11 None (open hole)
 2 Louvered shutter 4 Key punched 6 Wire wrapped 9 Drilled holes
 7 Torch cut 10 Other (specify)
 SCREEN-PERFORATED INTERVALS: From 340 ft. to 380 ft., From ft. to ft.
 From ft. to ft., From ft. to ft.
 GRAVEL PACK INTERVALS: From 300 ft. to 380 ft., From ft. to ft.
 From ft. to ft., From ft. to ft.

6 GROUT MATERIAL: 1 Neat cement 2 Cement grout 3 Bentonite 4 Other HOLE PLUG
 Grout Intervals: From 1 ft. to 20 ft., From ft. to ft., From ft. to ft.
 What is the nearest source of possible contamination:
 1 Septic tank 4 Lateral lines 7 Pit privy 10 Livestock pens 14 Abandoned water well
 2 Sewer lines 5 Cess pool 8 Sewage lagoon 11 Fuel storage 15 Oil well/Gas well
 3 Watertight sewer lines 6 Seepage pit 9 Feedyard 12 Fertilizer storage 16 Other (specify below)
 13 Insecticide storage
 Direction from well? How many feet?

FROM	TO	LITHOLOGIC LOG	FROM	TO	PLUGGING INTERVALS
0	4	TOP	344	353	SAND & GRAVEL
0	15	CLAY	353	362	CLAY
15	78	SANDY CLAY	362	375	SAND & GRAVEL
78	122	SANDY CLAY & SAND STREAKS	375	380	BLUE CLAY
122	148	FINE SAND			
148	159	CLAY			
159	173	SANDY CLAY			
173	190	CLAY			
190	247	SANDY CLAY			
247	278	SAND & LARGE GRAVEL			
278	295	SANDY CLAY			
295	314	SMALL GRAVEL			
314	330	SANDY CLAY			
330	338	SAND			
338	344	CLAY			

7 CONTRACTOR'S OR LANDOWNER'S CERTIFICATION: This water well was (1) constructed, (2) reconstructed, or (3) plugged under my jurisdiction and was completed on (mo/day/year) 9-22-94 and this record is true to the best of my knowledge and belief. Kansas Water Well Contractor's License No. KWWCL-430 This Water Well Record was completed on (mo/day/yr) 9-22-94 under the business name of HOWARD DRLG. CO. BOX 806 BEAVER, OK 73932 by (signature) *Howard Drlg. Co.*

INSTRUCTIONS: Use typewriter or ball point pen. PLEASE PRESS FIRMLY and PRINT clearly. Please fill in blanks, underline or circle the correct answers. Send top three copies to Kansas Department of Health and Environment, Bureau of Water, Topeka, Kansas 66620-0001. Telephone: 913-296-5545. Send one to WATER WELL OWNER and retain one for your records.