


1 LOCATION OF WATER WELL: Fraction W C 1/4 N 1/2 1/4 NE 1/4 Section Number 20 Township Number T 28 S Range Number R 37 E/W
 County: GRANT

Distance and direction from nearest town or city street address of well if located within city?
FROM 4 WAY STOP IN ULYSSES 1 WEST 2 NORTH, 1/2 WEST, 1/2 SOUTH, EAST TO WELL.

2 WATER WELL OWNER: MINTER-WILSON
 RR#, St. Address, Box # : W. HWY 50
 City, State, ZIP Code : GARDEN CITY, KS 67846
 Board of Agriculture, Division of Water Resources
 Application Number:

3 LOCATE WELL'S LOCATION WITH AN "X" IN SECTION BOX:

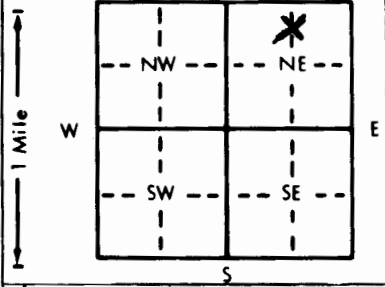

4 DEPTH OF COMPLETED WELL: 400 ft. ELEVATION:
 Depth(s) Groundwater Encountered 1. ft. 2. ft. 3. ft.
 WELL'S STATIC WATER LEVEL ft. below land surface measured on mo/day/yr 3-29-95
 Pump test data: Well water was ft. after hours pumping gpm
 Est. Yield gpm: Well water was ft. after hours pumping gpm
 Bore Hole Diameter: 9 1/2 in. to 400 ft. and in. to ft.
 WELL WATER TO BE USED AS: 5 Public water supply 8 Air conditioning 11 Injection well
 1 Domestic 3 Feedlot 6 Oil field water supply 9 Dewatering 12 Other (Specify below)
 2 Irrigation 4 Industrial 7 Lawn and garden only 10 Monitoring well
 Was a chemical/bacteriological sample submitted to Department? Yes No X; If yes, mo/day/yr sample was submitted
 Water Well Disinfected? Yes X No

5 TYPE OF BLANK CASING USED: 5 Wrought iron 8 Concrete tile CASING JOINTS: Glued X Clamped
 1 Steel 3 RMP (SR) 6 Asbestos-Cement 9 Other (specify below) Welded
 2 PVC 4 ABS 7 Fiberglass Threaded

Blank casing diameter . . . 5 in. to 400 ft., Dia in. to ft., Dia in. to ft.
 Casing height above land surface . . 24 in., weight 2.902 lbs./ft. Wall thickness or gauge No. 280 SDR 21

TYPE OF SCREEN OR PERFORATION MATERIAL: 7 PVC 10 Asbestos-cement
 1 Steel 3 Stainless steel 5 Fiberglass 8 RMP (SR) 11 Other (specify)
 2 Brass 4 Galvanized steel 6 Concrete tile 9 ABS 12 None used (open hole)

SCREEN OR PERFORATION OPENINGS ARE: 5 Gauzed wrapped 8 Saw cut 11 None (open hole)
 1 Continuous slot 3 Mill slot 6 Wire wrapped 9 Drilled holes
 2 Louvered shutter 4 Key punched 7 Torch cut 10 Other (specify)

SCREEN-PERFORATED INTERVALS: From . . . 260 ft. to . . . 400 ft., From ft. to ft.
 From ft. to ft., From ft. to ft.
 GRAVEL PACK INTERVALS: From . . . 240 ft. to . . . 400 ft., From ft. to ft.
 From ft. to ft., From ft. to ft.

6 GROUT MATERIAL: 1 Neat cement 2 Cement grout 3 Bentonite 4 Other HOLE PLUG
 Grout Intervals: From . . . 1 ft. to 20 ft., From ft. to ft., From ft. to ft.

What is the nearest source of possible contamination:
 1 Septic tank 4 Lateral lines 7 Pit privy 10 Livestock pens 14 Abandoned water well
 2 Sewer lines 5 Cess pool 8 Sewage lagoon 11 Fuel storage 15 Oil well/Gas well
 3 Watertight sewer lines 6 Seepage pit 9 Feedyard 12 Fertilizer storage 16 Other (specify below)
 13 Insecticide storage

Direction from well? How many feet?

FROM	TO	LITHOLOGIC LOG	FROM	TO	PLUGGING INTERVALS
0	2	TOP CLAY	274	280	SAND & SANDY CLAY
2	53	CLAY	280	305	SANDY CLAY
53	71	SANDY CLAY	305	313	BLUE CLAY
71	84	CLAY	313	340	CLAY
84	106	SANDY CLAY	340	362	SANDY CLAY W/SAND STREAKS
106	123	CLAY	362	383	SAND
123	164	SANDY CLAY	383	400	BLUE & BLACK CLAY
164	178	CLAY			
178	186	BLUE CLAY			
186	194	BLUE SANDY CLAY			
194	208	BLUE CLAY			
208	247	SANDY CLAY			
247	256	SAND			
256	266	COARSE SAND			
266	274	SANDY CLAY W/STREAKS			

7 CONTRACTOR'S OR LANDOWNER'S CERTIFICATION: This water well was (1) constructed, (2) reconstructed, or (3) plugged under my jurisdiction and was completed on (mo/day/year) 3-29-95 and this record is true to the best of my knowledge and belief. Kansas Water Well Contractor's License No. KNWCL-430 This Water Well Record was completed on (mo/day/year) 3-29-95 under the business name of HOWARD DRUG CO. BOX 806 BEAVER, OK 73932 by (signature) [Signature]

INSTRUCTIONS: Use typewriter or ball point pen. PLEASE PRESS FIRMLY and PRINT clearly. Please fill in blanks, underline or circle the correct answers. Send top three copies to Kansas Department of Health and Environment, Bureau of Water, Topeka, Kansas 66620-0001. Telephone: 913-296-5545. Send one to WATER WELL OWNER and retain one for your records.

#20566