


WATER WELL RECORD Form WWC-5 KSA 82a-1212

1 LOCATION OF WATER WELL: Fraction Section Number Township Number Range Number
 COUNTY: 034 GRANT NC WY2 09 T 28 S R 38 W

Distance and direction from nearest town or city street address of well if located within city?
 APPROX. 2 1/4 MILES NORTH AND 6 1/2 MILES WEST OF ULYSSES.

2 WATER WELL OWNER: DALE STEVENSON Board of Agriculture, Division of Water Resources
 RR#, St. Address, Box #: RFD 3
 City, State, ZIP code: ULYSSES, KS 67880- Application Number:

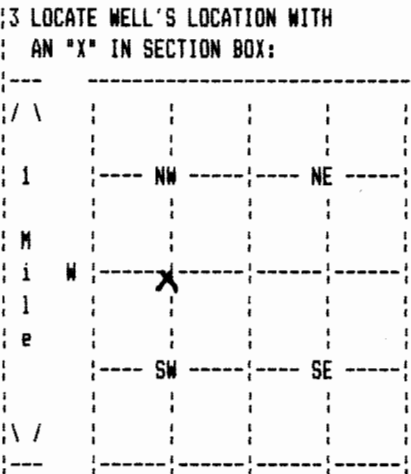

4 DEPTH OF COMPLETED WELL 261 ELEVATION: 0
 Depth(s) Groundwater Encountered 1. 0 ft. 2. 0 ft. 3. 0 ft.
 WELL'S STATIC WATER LEVEL 228 ft. below land surface measured on mo/day/yr 02/21/91
 Pump test data: Well water was 0 ft. after 0 hours pumping 0 gpm
 Estimated Yield 0 gpm: Well water was 0 ft. after 0 hours pumping 0 gpm
 Bore Hole Diameter in. to 0 ft., and in. to 0 ft.
 WELL WATER TO BE USED AS: 02 IRRIGATION
 Was a chemical/bacteriological sample submitted to department? No ;
 If yes, mo/day/yr sample was submitted Water well disinfected? Yes

5 TYPE OF BLANK CASING USED: 01 STEEL CASING JOINTS: WELDED
 Blank casing diameter 16 in. to 261 ft., Dia in. to 0 ft., Dia in. to 0 ft.
 Casing height above land surface -60 in., weight 0 lbs/ft. Wall thickness or gauge No.
 TYPE OF SCREEN OR PERFORATION MATERIAL: 01 STEEL
 SCREEN OR PERFORATION OPENINGS ARE: UNKNOWN

SCREEN PERFORATED INTERVALS: From 0 ft. to 0 ft., From 0 ft. to 0 ft.
 From 0 ft. to 0 ft., From 0 ft. to 0 ft.
 GRAVEL PACK INTERVALS: From 0 ft. to 0 ft., From 0 ft. to 0 ft.
 From 0 ft. to 0 ft., From 0 ft. to 0 ft.

6 GROUT MATERIAL 02 CEMENT GROUT
 Grout Intervals: From 3 ft. to 13 ft., From 0 ft. to 0 ft., From 0 ft. to 0 ft.
 What is the nearest source of possible contamination: NONE OBSERVED
 Direction from well? How many feet? 0

| FROM | TO | LITHOLOGIC LOG | FROM | TO | PLUGGING INTERVALS |
|------|----|----------------|------|-----|--------------------|
| | | | 0 | 3 | TOPSOIL |
| | | | 3 | 13 | CEMENT GROUT |
| | | | 13 | 228 | CLAY |
| | | | 228 | 261 | CHLORINATED SAND |
| | | | 0 | 0 | |
| | | | 0 | 0 | |
| | | | 0 | 0 | |
| | | | 0 | 0 | |
| | | | 0 | 0 | |
| | | | 0 | 0 | |

7 CONTRACTOR'S OR LANDOWNER'S CERTIFICATION: This water well was Plugged under my jurisdiction and was completed on (mo/day/year) 09/06/91 and this record is true to the best of my knowledge and belief. Kansas Water Well Contractor's License No. 145 This Water Well Record was completed on (mo/day/yr) 11/05/91 under the business name of HENKLE DRILLING & SUPPLY by (signature) Douglas B. Henkle