


WATER WELL RECORD Form WWC-5 KSA B2a-1212

1 LOCATION OF WATER WELL: ; Fraction ; Section Number ; Township Number ; Range Number  
 COUNTY: 034 GRANT ; SW 1/4 SW 1/4 SE 1/4 ; 09 ; T 28 S ; R 38 W

Distance and direction from nearest town or city street address of well if located within city?  
 APPROX. 5.75 MILES WEST AND 1.50 MILES NORTH OF ULYSSES.

2 WATER WELL OWNER: DALE STEVENSON  
 RR#, St. Address, Box #: 1169 W. ROAD B Board of Agriculture, Division of Water Resources  
 City, State, ZIP code : ULYSSES, KS 67880- Application Number: 22,537

3 LOCATE WELL'S LOCATION WITH AN "X" IN SECTION BOX: 4 DEPTH OF COMPLETED WELL 475 ELEVATION: 0  
 Depth(s) Groundwater Encountered 1. 190 ft. 2. 0 ft. 3. 0 ft.

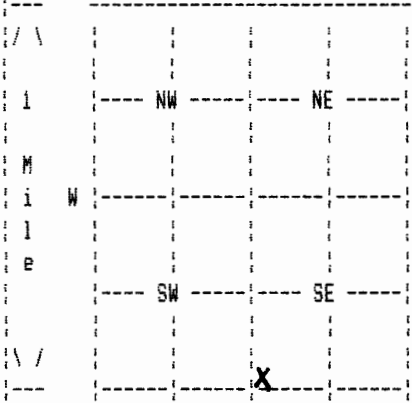

WELL'S STATIC WATER LEVEL 190 ft. below land surface measured on mo/day/yr 03/18/92  
 Pump testdata: Well water was 0 ft. after 0 hours pumping 0 gpm  
 Estimated Yield 0 gpm; Well water was 0 ft. after 0 hours pumping 0 gpm  
 Bore Hole Diameter in. to 0 ft., and in. to 0 ft.  
 WELL WATER WAS: 02 IRRIGATION  
 Was a chemical/bacteriological sample submitted to department? No ;  
 If yes, mo/day/yr sample was submitted Water well disinfected? Yes

5 TYPE OF BLANK CASING USED: 01 STEEL CASING JOINTS: WELDED  
 Blank casing diameter 16 in. to 475 ft., Dia in. to 0 ft., Dia in. to 0 ft.  
 Casing height above land surface -48 in., weight 0 lbs/ft. Wall thickness or gauge No.  
 TYPE OF SCREEN OR PERFORATION MATERIAL: 01 STEEL  
 SCREEN OR PERFORATION OPENINGS ARE: UNKNOWN

SCREEN PERFORATED INTERVALS: From 0 ft. to 0 ft., From 0 ft. to 0 ft.  
 GRAVEL PACK INTERVALS: From 0 ft. to 0 ft., From 0 ft. to 0 ft.  
 From 0 ft. to 0 ft., From 0 ft. to 0 ft.

6 GROUT MATERIAL 02 CEMENT GROUT  
 Grout Intervals: From 3 ft. to 13 ft., From 0 ft. to 0 ft., From 0 ft. to 0 ft.  
 What is the nearest source of possible contamination: NONE OBSERVED  
 Direction from well? How many feet? 0

FROM	TO	LITHOLOGIC LOG	FROM	TO	PLUGGING INTERVALS
			0	3	TOPSOIL
			3	13	CEMENT GROUT
			13	190	CLAY
			190	475	CHLORINATED SAND
			0	0	
			0	0	
			0	0	
			0	0	
			0	0	
			0	0	

7 CONTRACTOR'S OR LANDOWNER'S CERTIFICATION: This water well was Plugged under my jurisdiction and was completed on (mo/day/year) 03/18/92 and this record is true to the best of my knowledge and belief. Kansas Water Well Contractor's License No. 145 This Water Well Record was completed on (mo/day/yr) 06/12/92 under the business name of HENKLE DRILLING & SUPPLY by (signature) *Douglas B. Henkle*