

USE TYPEWRITER OR BALL POINT PEN-PRESS FIRMLY, PRINT CLEARLY.


WATER WELL RECORD
KSA 82a-1201-1215

T R EW sec 1/4 1/4 1/4 No.

Kansas State Dept. Of Health
(Water Well Contractors)
Forbes-Bldg. 740
Topeka, Kansas 66620

1 Location of well:	County Grant	Township name	Section number 18	Town number T 28 S	Range number R 38 W
---------------------	------------------------	---------------	-----------------------------	------------------------------	-------------------------------

Distance and direction from nearest town or city: 8 mi. West, 3 mi. North & 1/4 mi. West of Ulysses Street address of well location if in city:	3 Owner of well: Edward Dyck Address: c/o Bill Kimmel, 1st State Bank Hutchinson, Kansas 67501
--	---

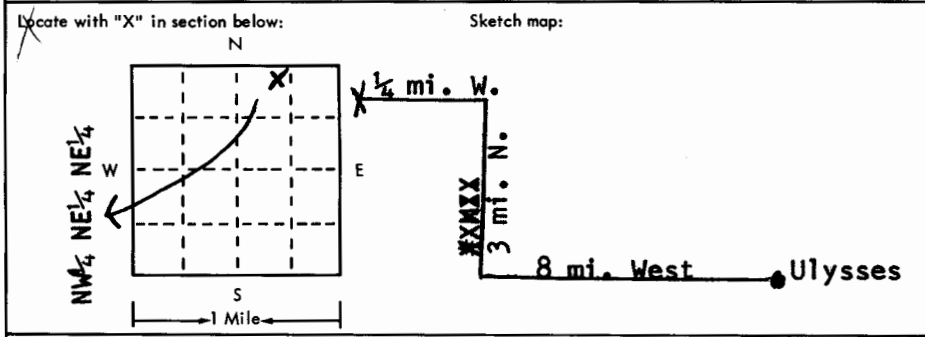

4 Well depth: **580** ft. Date of completion _____
Well diameter **26** in.

5 Cable tool Rotary Driven Dug
 Hollow rod Jetted Bored Reverse rotary

6 Use: Domestic Public supply Industry
 Irrigation Air conditioning Commercial
 Test well

7 Casing: Material **Steel** Height: above/below
Threaded Welded Surface **12** in.
Diam. **16** in. to **580** ft. depth Drive shoe? Yes No
Weight **34.5** lbs./ft. _____

2	Type and color of material	From	To
	Surface & Fine Sand	0	15
	Brown Sandy Clay - 65%	15	90
	Brown Clay With Fine Sand Strips	90	210
	Sand	210	225
	Brown Clay	225	245
	Coarse Sand & Rock	245	260
	Brown Clay	260	375
	Coarse Sand with some Lava Rock & Sandstone	375	420
	Brown Clay & Lava Rock	420	430
	Blue Shale	430	495
	Blue Shale, Gray Clay & some Cheyenne	495	510
	Gray Clay, Brown Shale & Cheyenne	510	570
	Blue & Brown XXXX Shale	570	610
	Red Clay	610	615
	(use a second sheet if needed)		

8 Screen:
Manufacturer **Johnson**
Type **Galvanized** Dia. **16** in.
Slot/gauge **100X100** Length **40** ft.
Set between **385** ft. and **405** ft. **540** * **560**
Fittings: * **See remarks**
Gravel pack Yes No Size range of material **1/2** down

9 Static water level:
210 ft. below land surface Date **3-29-76**

10 Pumping level below land surfaces:
520 ft. after **6** hrs. pumping **450** g.p.m.
_____ ft. after _____ hrs. pumping _____ g.p.m.
Estimated maximum yield **450** g.p.m.

11 Water sample submitted:
 Yes No Date _____

12 Well head completion: **12** in.
 Pitless adapter Inches above grade

13 Well grouted? Yes No
 Neat cement Bentonite _____
Depth: From **0** ft. to **10** ft.

14 Nearest source of possible contamination:
ft. _____ Direction _____ Type _____
Well disinfected upon completion? Yes No

15 Pump: Not installed
Manufacturer's name **Fairbanks Morse**
Model number **11M** HP **150** Volts _____
Length of drop pipe **550** ft. capacity **600** g.p.m.
Type:
 Submersible Turbine
 Jet Reciprocating
 Centrifugal Other

16 Remarks: elevation

Drilling Sub-contracted to:
Minter-Wilson Drilling Co. License #208
Garden City, Kansas 67846
*** Lakewood Perf. - Slot - 125 X 66**
Set between 375' & 385', 405' & 540',
560' & 580'

Topography:
 Hill
 Slope
 Upland
 Valley

17 Water well contractor's certification:
This well was drilled under my jurisdiction and this report is true to the best of my knowledge and belief.
K. J. Drilling Co., Inc. 263
Business name License No. _____
Address **Box 669, Ulysses, Kn. 67880**
Signed **M. Joyce Brasher** Date **4-21-76**
Authorized representative

28 38 W 18 NW NE NE