


1 LOCATION OF WATER WELL: County: Grant	Fraction NC 1/4 NC 1/4 SE 1/4	Section Number 20	Township Number T 28 S	Range Number R 38 EW
--	----------------------------------	----------------------	---------------------------	-------------------------

Distance and direction from nearest town or city street address of well if located within city?

From 4 way stop @ Ulysses: 7W, 1n, 1/2W & N into--

2 WATER WELL OWNER: RR#, St. Address, Box # : City, State, ZIP Code :	Weber Supply Hwy 60 West, 2718 W Oklahoma Ulysses, KS 67880	Harry Morris Well Board of Agriculture, Division of Water Resources Application Number:
---	---	---

3 LOCATE WELL'S LOCATION WITH AN "X" IN SECTION BOX:

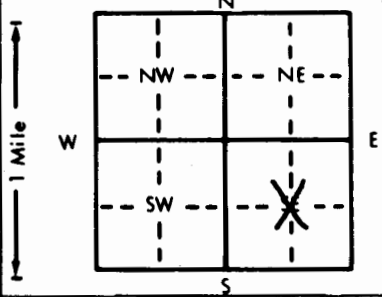

4 DEPTH OF COMPLETED WELL: 420 ft.	ELEVATION:
Depth(s) Groundwater Encountered 1. 150 ft. 2. ft. 3. ft.	
WELL'S STATIC WATER LEVEL .150 ft. below land surface measured on mo/day/yr 10/30/92	
Pump test data: Well water was 265 ft. after 1 hours pumping 80 gpm	
Est. Yield .80 gpm: Well water was ft. after hours pumping gpm	
Bore Hole Diameter 9 1/2 in. to 420 ft., and in. to ft.	
WELL WATER TO BE USED AS:	
<input checked="" type="checkbox"/> Domestic <input type="checkbox"/> Irrigation <input type="checkbox"/> 3 Feedlot <input type="checkbox"/> 4 Industrial <input type="checkbox"/> 5 Public water supply <input type="checkbox"/> 6 Oil field water supply <input type="checkbox"/> 7 Lawn and garden only <input type="checkbox"/> 8 Air conditioning <input type="checkbox"/> 9 Dewatering <input type="checkbox"/> 10 Monitoring well <input type="checkbox"/> 11 Injection well <input type="checkbox"/> 12 Other (Specify below)	
Was a chemical/bacteriological sample submitted to Department? Yes No X; If yes, mo/day/yr sample was submitted	
Water Well Disinfected? Yes X No	

5 TYPE OF BLANK CASING USED:	5 Wrought iron	8 Concrete tile	CASING JOINTS: Glued X Clamped
1 Steel	3 RMP (SR)	6 Asbestos-Cement	9 Other (specify below)
<input checked="" type="checkbox"/> PVC	4 ABS	7 Fiberglass	Welded
Blank casing diameter .5 in. to 420 ft., Dia in. to ft., Dia in. to ft.			Threaded
Casing height above land surface .24 in., weight 2.902 lbs./ft. Wall thickness or gauge No. 280 SDR-21			
TYPE OF SCREEN OR PERFORATION MATERIAL:	<input checked="" type="checkbox"/> PVC	10 Asbestos-cement	
1 Steel	3 Stainless steel	5 Fiberglass	8 RMP (SR)
2 Brass	4 Galvanized steel	6 Concrete tile	9 ABS
11 Other (specify)			12 None used (open hole)
SCREEN OR PERFORATION OPENINGS ARE:	5 Gauzed wrapped	<input checked="" type="checkbox"/> Saw cut	11 None (open hole)
1 Continuous slot	3 Mill slot	6 Wire wrapped	9 Drilled holes
2 Louvered shutter	4 Key punched	7 Torch cut	10 Other (specify)
SCREEN-PERFORATED INTERVALS: From 300 ft. to 320 ft., From 340 ft. to 420 ft.			
GRAVEL PACK INTERVALS: From 220 ft. to 420 ft., From ft. to ft.			

6 GROUT MATERIAL:	<input checked="" type="checkbox"/> Neat cement	2 Cement grout	3 Bentonite	<input checked="" type="checkbox"/> Other	Hole Plug
Grout intervals: From 1 ft. to 20 ft., From ft. to ft., From ft. to ft.					
What is the nearest source of possible contamination:	1 Septic tank	4 Lateral lines	7 Pit privy	10 Livestock pens	14 Abandoned water well
	2 Sewer lines	5 Cess pool	8 Sewage lagoon	11 Fuel storage	15 Oil well/Gas well
	3 Watertight sewer lines	6 Seepage pit	9 Feedyard	12 Fertilizer storage	16 Other (specify below)
				13 Insecticide storage	
Direction from well?				How many feet?	

FROM	TO	LITHOLOGIC LOG	FROM	TO	PLUGGING INTERVALS
0	2	Surface Soil			
2	48	Clay			
48	95	Sandy Clay			
95	110	Clay & Sandy Clay			
110	223	Sand & Sandy Clay			
223	278	Clay			
278	315	Sand & Gravel			
315	338	Clay			
338	358	Sand			
358	362	Clay			
362	408	Sand			
408	420	Clay			

7 CONTRACTOR'S OR LANDOWNER'S CERTIFICATION: This water well was constructed, reconstructed, or plugged under my jurisdiction and was completed on (mo/day/year) 10/30/92 and this record is true to the best of my knowledge and belief. Kansas Water Well Contractor's License No. KWWCL-430 This Water Well Record was completed on (mo/day/yr) 10/30/92 under the business name of Howard Drlg. Co., Box 806 Beaver, OK 73932 by (signature) *Oliver Howard*

INSTRUCTIONS: Use typewriter or ball point pen. PLEASE PRESS FIRMLY and PRINT clearly. Please fill in blanks, underline or circle the correct answers. Send top three copies to Kansas Department of Health and Environment, Bureau of Water, Topeka, Kansas 66620-0001. Telephone: 913-296-5545. Send one to WATER WELL OWNER and retain one for your records.