

USE TYPEWRITER OR BALL POINT PEN—PRESS FIRMLY, PRINT CLEARLY.


WATER WELL RECORD
KSA 82a-1201-1215

T R EW sec 1/4 1/4 1/4 No.

Kansas State Dept. Of Health
(Water Well Contractors)
Forbes-Bldg. 740
Topeka, Kansas 66620

1 Location of well:	County Grant	Township name	Fraction NE$\frac{1}{4}$, NE$\frac{1}{4}$, SW$\frac{1}{4}$	Section number 24	Town number T28S	Range number R38W
---------------------	------------------------	---------------	---	-----------------------------	----------------------------	-----------------------------

Distance and direction from nearest town or city: 1 mi. N., 3$\frac{1}{2}$ mi. West, $\frac{1}{2}$ mi. N. & 100 Ft. W. Street address of well location if in city: of Ulysses	3 Owner of well: C. E. Battin Address: 409 South Maxwell Ulysses, Kansas 67880
---	---

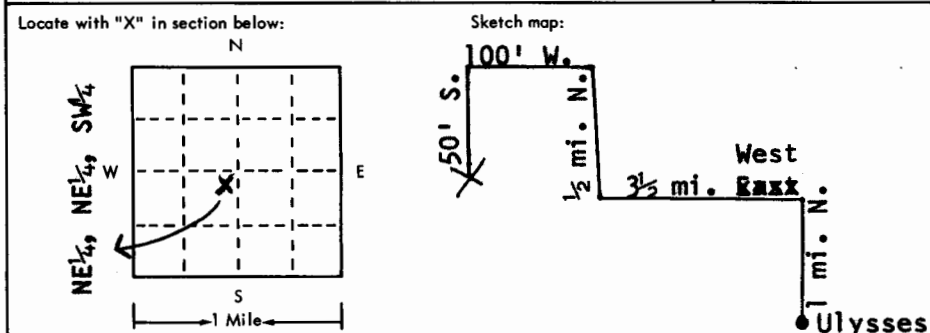

4 Well depth: 550 ft. Date of completion: 1-28-76 Well diameter 26 in.
5 <input type="checkbox"/> Cable tool <input type="checkbox"/> Rotary <input type="checkbox"/> Driven <input type="checkbox"/> Dug <input type="checkbox"/> Hollow rod <input type="checkbox"/> Jetted <input type="checkbox"/> Bored <input checked="" type="checkbox"/> Reverse rotary
6 Use: <input type="checkbox"/> Domestic <input type="checkbox"/> Public supply <input type="checkbox"/> Industry <input checked="" type="checkbox"/> Irrigation <input type="checkbox"/> Air conditioning <input type="checkbox"/> Commercial <input type="checkbox"/> Test well <input type="checkbox"/>
7 Casing: Material Steel Height: above/below Threaded <input type="checkbox"/> Welded <input checked="" type="checkbox"/> Surface 12 in. Diam. Weight 34$\frac{1}{2}$ lbs./ft. 16 in. to 550 ft. depth! Drive shoe? <input type="checkbox"/> Yes <input checked="" type="checkbox"/> No

2	Type and color of material	From	To
	Surface & Brown Clay	0	15
	Brown Clay	15	45
	Fine to Medium Sand	45	75
	Brown Clay	75	247
	Coarse Sand	247	280
	Brown Clay	280	288
	Coarse Sand with Cemented Strips	288	318
	Brown Clay	318	345
	Coarse Sand, Gravel & 5 ft. Clay Strip	345	375
	Blue Shale	375	458
	Blue Shale & Sandstone (Took Water)	458	503
	Blue Shale	503	510
	Sandstone	510	533
	Rock	533	537
	Sandstone	537	550
	Blue Shale, Rock & Red Bed. - (565) <small>(Use a second sheet if needed)</small>	550	560

8 Screen: Manufacturer Johnson Type Galvanized Dia. 16 in. Slot 100X100 Length 60 ft. Set between 355 ft. and 375 ft. & 455 & 495 Fittings: See Remarks Gravel pack <input checked="" type="checkbox"/> Yes <input type="checkbox"/> No Size range of material: 1/2 down
9 Static water level: 170 ft. below land surface Date 1-30-76
10 Pumping level below land surfaces: 233 ft. after 2 hrs. pumping 650 g.p.m. ____ ft. after ____ hrs. pumping ____ g.p.m. Estimated maximum yield 1000 g.p.m.
11 Water sample submitted: <input type="checkbox"/> Yes <input checked="" type="checkbox"/> No Date _____
12 Well head completion: 12 in. <input type="checkbox"/> Pitless adapter <input checked="" type="checkbox"/> Inches above grade
13 Well grouted? <input checked="" type="checkbox"/> Yes <input type="checkbox"/> No <input checked="" type="checkbox"/> Neat cement <input checked="" type="checkbox"/> Bentonite <input type="checkbox"/> _____ Depth: From 0 ft. to 10 ft.
14 Nearest source of possible contamination: ft. _____ Direction none in field Type _____ Well disinfected upon completion? <input type="checkbox"/> Yes <input checked="" type="checkbox"/> No
15 Pump: <input type="checkbox"/> Not installed Manufacturer's name Goulds Model number 12M HP 200 Volts _____ Length of drop pipe 530 ft. capacity 1200 g.p.m. Type: <input type="checkbox"/> Submersible <input checked="" type="checkbox"/> Turbine <input type="checkbox"/> Jet <input type="checkbox"/> Reciprocating <input type="checkbox"/> Centrifugal <input type="checkbox"/> Other

16 Remarks: elevation

Drilling Sub-Contracted to:
Minter-Wilson Drilling Co. License #208
Garden City, Kansas 67846
*** Lakewood Perf. - Slot - 125' X 66**
set Between 285' & 355' and 375' & 455'
and 495' & 550'

Topography:
 Hill
 Slope
 Upland
 Valley

17 Water well contractor's certification:
This well was drilled under my jurisdiction and this report is true to the best of my knowledge and belief.

K. I. Drilling Co., Inc. 263
Business name License No.
Address **Box 669, Ulysses, Kan.**
Signed **M. Joyce Brash** Date **2-4-76**
Authorized representative

28 38W 24 NE NESW