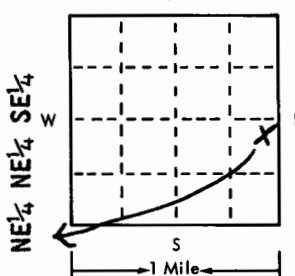
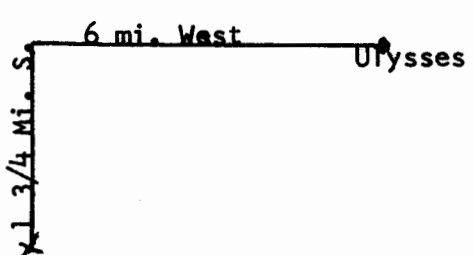


USE TYPEWRITER OR BALL POINT PEN-PRESS FIRMLY, PRINT CLEARLY.

WATER WELL RECORD
KSA 82a-1201-1215

T R EW sec 1/4 1/4 1/4 No.

Kansas State Dept. Of Health
(Water Well Contractors)
Forbes-Bldg. 740
Topeka, Kansas 66620

1 Location of well:	County Grant	Township name	Fraction NE$\frac{1}{4}$, NE$\frac{1}{4}$, SE$\frac{1}{4}$	Section number 33	Town number T 28 S	Range number R 38 W
Distance and direction from nearest town or city: 6 mi. West & 1 3/4 Mi. South of Ulysses Street address of well location if in city:				3 Owner of well: Richard M. Noel Address: 113 North Neil Champaign, Ill/ 61820		
Locate with "X" in section below: N 		Sketch map: 		4 Well depth: 530 ft. Date of completion _____ Well diameter 26 in.		
2 Type and color of material				5 <input type="checkbox"/> Cable tool <input type="checkbox"/> Rotary <input type="checkbox"/> Driven <input type="checkbox"/> Dug <input type="checkbox"/> Hollow rod <input type="checkbox"/> Jetted <input type="checkbox"/> Bored <input checked="" type="checkbox"/> Reverse rotary		
				6 Use: <input type="checkbox"/> Domestic <input type="checkbox"/> Public supply <input type="checkbox"/> Industry <input checked="" type="checkbox"/> Irrigation <input type="checkbox"/> Air conditioning <input type="checkbox"/> Commercial <input type="checkbox"/> Test well <input type="checkbox"/> _____		
From To				7 Casing: Material Steel Height: above/below _____ Threading: <input type="checkbox"/> Threaded <input type="checkbox"/> Welded <input checked="" type="checkbox"/> Surface 12 in. Diam. _____ Weight 34.5 lbs./ft. _____ 16 in. to 530 ft. depth Drive shoe? <input type="checkbox"/> Yes <input checked="" type="checkbox"/> No _____ in. to _____ ft. depth		
				8 Screen: Manufacturer JMXXX Johnson Type Galvanized Dia. 16 in. Slot/gauge 100X100 Length 60 ft. Set between 325 ft. and 345 ft. 420 & 450 Fittings: *See remarks 510 & 520 Gravel pack <input checked="" type="checkbox"/> Yes <input type="checkbox"/> No Size range of material 1/2 down		
Surface & Fine to Medium Sand				9 Static water level: 253 ft. below land surface Date 4-3-76		
				10 Pumping level below land surfaces: 320 ft. after 2 hrs. pumping 1000 g.p.m. _____ ft. after _____ hrs. pumping _____ g.p.m. Estimated maximum yield 1200 g.p.m.		
Brown Clay with Sand Strips				11 Water sample submitted: <input type="checkbox"/> Yes <input checked="" type="checkbox"/> No Date _____		
				12 Well head completion: 12 in. <input type="checkbox"/> Pitless adapter <input checked="" type="checkbox"/> Inches above grade <input checked="" type="checkbox"/> Well grouted? <input checked="" type="checkbox"/> Yes <input type="checkbox"/> No <input checked="" type="checkbox"/> Neat cement <input checked="" type="checkbox"/> Bentonite <input type="checkbox"/> _____ Depth: From _____ ft. to _____ ft.		
Sand				14 Nearest source of possible contamination: ft. _____ Direction None in field Type _____ Well disinfected upon completion? <input type="checkbox"/> Yes <input checked="" type="checkbox"/> No		
				15 Pump: <input type="checkbox"/> Not installed Manufacturer's name Fairbanks Morse Model number 121 HP 200 Volts _____ Length of drop pipe 500 ft. capacity 1200 g.m.p. Type: <input type="checkbox"/> Submersible <input checked="" type="checkbox"/> Turbine <input type="checkbox"/> Jet <input type="checkbox"/> Reciprocating <input type="checkbox"/> Centrifugal <input type="checkbox"/> Other		
Brown Clay with Sand Strip - 195 to 210				16 Remarks: elevation Drilling Con-tracted to: Minter-Wilson Drilling Co. License Garden City, Kn. 67846 #208 * Lakewood Perf. - Slot - 125 X 66 Set between 310' & 325', 345' & 420', 450' & 510', 520' & 530'		
				17 Water well contractor's certification: This well was drilled under my jurisdiction and this report is true to the best of my knowledge and belief. K. I. Drilling Co., Inc. 263 Business name License No. _____ Address Box 669, Ulysses, Kn. 67880 Signed M. Joyce B... Date 4-21-76 Authorized representative		
Clay & Fine Sand				16 Remarks: elevation <input checked="" type="checkbox"/> Hill <input checked="" type="checkbox"/> Slope <input type="checkbox"/> Upland <input type="checkbox"/> Valley		
				(use a second sheet if needed)		
Clay, Lava & Some Medium Gravel				16 Remarks: elevation		
White Sandstone				16 Remarks: elevation		
Brown Shale & Gray Clay				16 Remarks: elevation		

Forward the white, blue and pink copies to the Kansas State Dept. Of Health.

Form WWC-5

28 38W 33 NE NESE