

WATER WELL PLUGGING RECORD Form WWC-5P KSA 82a-1212 ID NO.


1 LOCATION OF WATER WELL: County: <u>Grant</u>	Fraction <u>1/4 SW 1/4 SW 1/4 SE 1/4</u>	Section Number <u>32</u>	Township Number <u>T 28 S</u>	Range Number <u>38</u> <input type="checkbox"/> E <input checked="" type="checkbox"/> W
--	---	-----------------------------	----------------------------------	--

Street Rural Address of Well Location: if unknown, distance & direction from nearest town or intersection: If at owner's address, check here Hwy 160 & 25 7 miles west on hwy 160

1 miles south 532.9' north of south line 2505.3' west

2 WATER WELL OWNER: BP America Production Co.
RR#, St. Address, Box #: 2225 W. Oklahoma Ave.
City, State ZIP Code: Ulysses, KS 67880

Global Positioning Systems (GPS) information:
Latitude: _____ (in decimal degrees)
Longitude: _____ (in decimal degrees)
Elevation: _____
Datum: WGS84. NAD83. NAD27
Collection Method:
 GPS unit (Make Model: _____)
 Digital Map Photo. Topographic Map. Land Survey
Est. Accuracy: 3 m. 3-5 m. 5-15 m. 15 m

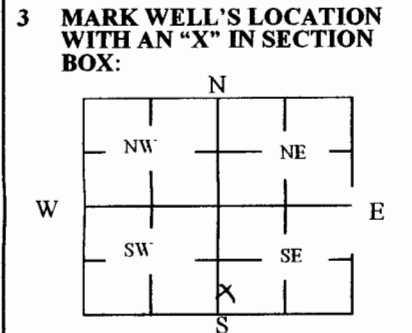

4 DEPTH OF WELL 550 ft.
WELL'S STATIC WATER LEVE 245 ft.
WELL WAS USED AS:
 Domestic Public Water Supply Dewatering
 Irrigation Oil Field Water Supply Monitoring
 Feedlot Domestic (Lawn & Garden) Injection Well
 Industrial Air Conditioning Other _____
Was a chemical/bacteriological sample submitted to Department? Yes No

5 TYPE OF BLANK CASING USED:
 Steel RMP (SR) Wrought Fiberglass Other (Specify below)
 PVC ABS Asbestos-Cement Concrete Tile _____
Blank casing diameter 16 in. Was casing pulled? Yes No If yes, how much _____
Casing height above or below land surface 72 in.

6 GROUT PLUG MATERIAL: Neat cement Cement grout Bentonite Other _____
Grout Plug Intervals: From 5 ft. to 30 ft., From 235 ft. to 240 ft., From _____ to _____ ft.
What is the nearest source of possible contamination:
 Septic tank Seepage pit Fuel Storage Other (specify below) _____
 Sewer lines Pit privy Fertilizer storage _____
 Watertight sewer lines Sewage lagoon Insecticide storage _____
 Lateral lines Feedyard Abandoned water well Direction from well? _____
 Cess pool Livestock pens Oil well/Gas well How many feet? _____

FROM	TO	PLUGGING MATERIALS	FROM	TO	PLUGGING MATERIALS
0	5	Top Soil			
5	30	Cement Grout			
30	235	Chlorinated Gravel			
235	240	Bentonite Grout			
240	550	Chlorinated Gravel			

7 CONTRACTOR'S OR LANDOWNER'S CERTIFICATION: This water well was plugged under my jurisdiction and was completed on (mo/day/year) 5/13/09 and this record is true to the best of my knowledge and belief. Kansas Water Well Contractor's License No. 775. This Water Well Record was completed on (mo/day/year) 5/14/09 under the business name of Martin's Well Service by (signature) Kenny Martin

INSTRUCTIONS: Use typewriter or ballpoint pen. Please press firmly and print clearly. Please fill in blanks, underline or circle the correct answers. Send top three copies to Kansas Department of Health and Environment, Bureau of Water, Geology Section, 1000 SW Jackson St., Ste. 420, Topeka, Kansas 66612-1367. Telephone: 785/296-5524. Send one to Water Well Owner and retain one for your records. Visit us at <http://www.kdheks.gov/waterwell/index.html>.

Check one: White Copy Blue Copy Pink Copy