


1 LOCATION OF WATER WELL: Fraction Section Number Township Number Range Number
 COUNTY: 094 STANTON SE 1/4 SW 1/4 SE 1/4 33 T 28 S R 39 W

Distance and direction from nearest town or city street address of well if located within city?
 FROM BIG BOW; APPX 1 MILE WEST

2 WATER WELL OWNER: R & E FAMILY FARMS
 RR#, St. Address, Box # : 6185 N. G ROAD Board of Agriculture, Division of Water Resources
 City, State, ZIP code : JOHNSON, KS 67855-8861 Application Number: 8593

3 LOCATE WELL'S LOCATION WITH AN "X" IN SECTION BOX:

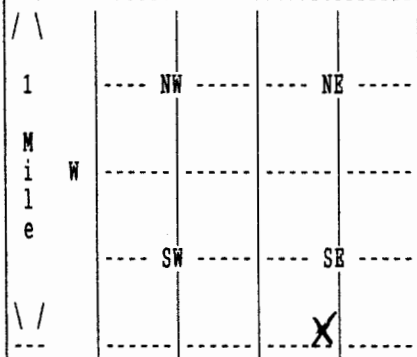

4 DEPTH OF COMPLETED WELL 594 ELEVATION: 0
 Depth(s) Groundwater Encountered 1. 0 ft. 2. 0 ft. 3. 0 ft.

WELL'S STATIC WATER LEVEL 330 ft. below land surface measured on mo/day/yr 07/02/05
 Pump test data: Well water was 384 ft. after 4 hours pumping 500 gpm

Estimated Yield 0 gpm: Well water was 0 ft. after 0 hours pumping 0 gpm

Bore Hole Diameter 24 in. to 594 ft., and in. to 0 ft.

WELL WATER TO BE USED AS: 02 IRRIGATION

Was a chemical/bacteriological sample submitted to department? No ;
 If yes, mo/day/yr sample was submitted Water well disinfected? Yes

5 TYPE OF BLANK CASING USED: 01 STEEL CASING JOINTS: WELDED
 Blank casing diameter 16 in. to 594 ft., Dia in. to 0 ft., Dia in. to 0 ft.
 Casing height above land surface 12 in., weight 42 lbs/ft. Wall thickness or gauge No. .250
 TYPE OF SCREEN OR PERFORATION MATERIAL: 01 STEEL
 SCREEN OR PERFORATION OPENINGS ARE: 01 CONT. SLOT

SCREEN PERFORATED INTERVALS: From 339 ft. to 589 ft., From 0 ft. to 0 ft.
 From 0 ft. to 0 ft., From 0 ft. to 0 ft.
 GRAVEL PACK INTERVALS: From 20 ft. to 594 ft., From 0 ft. to 0 ft.
 From 0 ft. to 0 ft., From 0 ft. to 0 ft.

6 GROUT MATERIAL 03 BENTONITE
 Grout Intervals: From 0 ft. to 20 ft., From 0 ft. to 0 ft., From 0 ft. to 0 ft.
 What is the nearest source of possible contamination: 14 ABAND. WELL
 Direction from well? SOUTHEAST How many feet? 153

| FROM | TO | LITHOLOGIC LOG | FROM | TO | PLUGGING INTERVALS |
|------|-----|-------------------------------------|------|----|--------------------|
| 0 | 2 | 02 SILT | | | |
| 2 | 8 | 01 CLAY 31 CALICHE | | | |
| 8 | 23 | 07 FINE SAND 08 MEDIUM SAND | | | |
| 23 | 42 | 01 CLAY | | | |
| 42 | 54 | 07 FINE SAND | | | |
| 54 | 94 | 01 CLAY 05 SAND | | | |
| 94 | 117 | 07 FINE SAND 08 MEDIUM SAND 01 CLAY | | | |
| 117 | 178 | 01 CLAY | | | |
| 178 | 223 | 07 FINE SAND 08 MEDIUM SAND 01 CLAY | | | |
| 223 | 254 | 01 CLAY 05 SAND | | | |

7 CONTRACTOR'S OR LANDOWNER'S CERTIFICATION: This water well was Constructed under my jurisdiction and was completed on (mo/day/year) 06/30/05 and this record is true to the best of my knowledge and belief. Kansas Water Well Contractor's License No. 145 This Water Well Record was completed on (mo/day/yr) 08/09/05 under the business name of HENKLE DRILLING & SUPPLY by (signature)

| | | | | |
|--|----------------------------------|----------------------|---------------------------|------------------------|
| 1 LOCATION OF WATER WELL: COUNTY: 094 STANTON | Fraction SE 1/4 SW 1/4 SE 1/4 | Section Number 33 | Township Number T 28 S | Range Number R 39 W |
|--|----------------------------------|----------------------|---------------------------|------------------------|

2 WATER WELL OWNER: R & E FAMILY FARMS
 RR#, St. Address, Box # : 6185 N. G ROAD
 City, State, ZIP code : JOHNSON, KS 67855-8861

Board of Agriculture, Division of Water Resources
 Application Number: 8593

| FROM | TO | LITHOLOGIC LOG |
|------|-----|--------------------------------------|
| 254 | 270 | 07 FINE SAND 08 MEDIUM SAND |
| 270 | 291 | 01 CLAY 05 SAND |
| 291 | 344 | 01 CLAY 20 LIMESTONE 05 SAND |
| 344 | 360 | 05 SAND 13 FINE GRAVEL 28 ROCK |
| 360 | 382 | 01 CLAY |
| 382 | 393 | 07 FINE SAND |
| 393 | 399 | 01 CLAY |
| 399 | 414 | 07 FINE SAND |
| 414 | 419 | 01 CLAY |
| 419 | 433 | 05 SAND |
| 433 | 439 | 01 CLAY |
| 439 | 446 | 07 FINE SAND |
| 446 | 456 | 28 ROCK |
| 456 | 485 | 31 CALICHE 23 SANDSTONE |
| 485 | 489 | 01 CLAY |
| 489 | 500 | 31 CALICHE 23 SANDSTONE |
| 500 | 504 | 01 CLAY |
| 504 | 523 | 23 SANDSTONE 31 CALICHE |
| 523 | 534 | 31 CALICHE 20 LIMESTONE 23 SANDSTONE |
| 534 | 545 | 31 CALICHE 23 SANDSTONE |
| 545 | 565 | 31 CALICHE 23 SANDSTONE |
| 565 | 589 | 31 CALICHE 23 SANDSTONE |
| 589 | 607 | 31 CALICHE 20 LIMESTONE 23 SANDSTONE |
| 607 | 620 | 31 CALICHE 19 SHALE |
| 620 | 625 | 19 SHALE |

7 CONTRACTOR'S OR LANDOWNER'S CERTIFICATION: This water well was Constructed under my jurisdiction and was completed on (mo/day/year) 06/30/05 and this record is true to the best of my knowledge and belief. Kansas Water Well Contractor's License No. 145 This Water Well Record was completed on (mo/day/yr) 08/09/05 under the business name of HENKLE DRILLING & SUPPLY by (signature) *Bryan R. Kirk*