


1	LOCATION OF WATER WELL:	Fraction	Section Number	Township Number	Range Number
County: Stanton	SE, ^{SW} 1/4 1/4 SW 1/4	35	28	39	E/W

Distance and direction from nearest town or city street address of well if located within city?

2 WATER WELL OWNER: Skyland Grain
 RR #, St. Address, Box # 951 S. Big Bow Grade Board of Agriculture, Division of Water Resources
 City, State, ZIP Code Big Bow, KS 67855 Application Number:

3	MARK WELL'S LOCATION WITH AN "X" IN SECTION BOX:	4	DEPTH OF WELL 115 ft. WELL'S STATIC WATER LEVEL 0 ft. WELL WAS USED AS: 1 Domestic 2 Irrigation 3 Feedlot 4 Industrial 5 Public Water Supply 6 Oil Field Water Supply 7 Domestic (Lawn & Garden) 8 Air Conditioning 9 Dewatering 10 Monitoring Well 11 Injection Well 12 Other
---	--	---	--

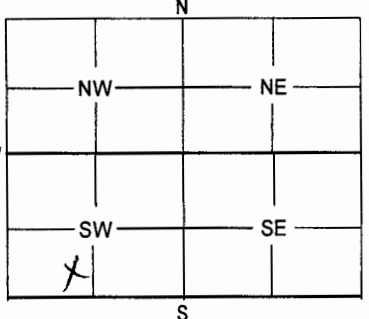

Was a chemical / bacteriological sample submitted to Department? Yes No X
 if yes, mo/day/yr sample was submitted

Water Well Disinfected: Yes No X

5 TYPE OF BLANK CASING USED:

1 Steel 2 PVC 3 RMP (SR) 4 ABS 5 Wrought 6 Asbestos-Cement 7 Fiberglass 8 Concrete Tile 9 Other (Specify below)

Blank casing diameter 4 in. Was casing pulled? Yes X No If yes, how much 3'

Casing height above or below land surface 36 in.

6 GROUT PLUG MATERIAL: 1 Neat cement 2 Cement grout 3 Bentonite 4 Other Cement

GROUT PLUG INTERVALS: From 115 ft. to 1 ft., From 1 ft. to 0 ft., From to ft.

What is the nearest source of possible contamination:
 1 Septic tank 2 Sewer lines 3 Watertight sewer lines 4 Lateral lines 5 Cess pool
 6 Seepage pit 7 Pit privy 8 Sewage lagoon 9 Feedyard 10 Livestock pens
 11 Fuel storage 12 Fertilizer storage 13 Insecticide storage 14 Abandoned water well 15 Oil well/Gas well
 16 Other (specify below) Grain Elevator

Direction from well? 999 How many feet? 999

FROM	TO	PLUGGING MATERIALS
115'	1'	Bentonite
1'	0"	Cement

MWC-1

7 CONTRACTOR'S OF LANDOWNER'S CERTIFICATION: This water well was plugged under my jurisdiction and was completed on (mo/day/year) 09-10-07 and this record is true to the best of my knowledge and belief. Kansas Water Well Contractor's License No. 665 This Water Well Record was completed on (mo/day/year) 10-11-07 under the business name of Pratt Well Environmental by (signature) *Steven Ewell*

INSTRUCTIONS: Use typewriter or ball point pen. Please press firmly and print clearly. Please fill in blanks, underline or circle the correct answers. Send top three copies to Kansas Department of Health and Environment, Bureau of Water, Geology Section, 1 000 SW Jackson St., Ste. 420, Topeka, Kansas 66612-1367. Telephone: 785/296-5522. Send one to Water Well Owner and retain one for your records.