


1 LOCATION OF WATER WELL:	Fraction	Section	Number	Township	Number	Range	Number
County: Stanton	SE, <sup>SW</sup> <sub>1/4 1/4</sub> <sub>1/4</sub> SW <sub>1/4</sub>	35		28		39	<span style="border: 1px solid black; border-radius: 50%; padding: 2px;">EW</span>

Distance and direction from nearest town or city street address of well if located within city?

2 WATER WELL OWNER: Skyland Grain  
 RR #, St. Address, Box # 951 S. Big Bow Grade  
 City, State, ZIP Code Big Bow, KS 67855

Board of Agriculture, Division of Water Resources  
 Application Number:

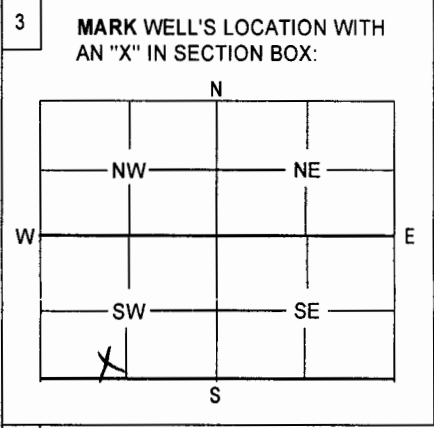

4 DEPTH OF WELL 97 ft.  
 WELL'S STATIC WATER LEVEL 0 ft.

WELL WAS USED AS:

1 Domestic	5 Public Water Supply	9 Dewatering
2 Irrigation	6 Oil Field Water Supply	<span style="border: 1px solid black; border-radius: 50%; padding: 2px;">10</span> Monitoring Well
3 Feedlot	7 Domestic (Lawn & Garden)	11 Injection Well
4 Industrial	8 Air Conditioning	12 Other

Was a chemical / bacteriological sample submitted to Department? Yes No  X  
 if yes, mo/day/yr sample was submitted

Water Well Disinfected: Yes No  X

5 TYPE OF BLANK CASING USED:

1 Steel	3 RMP (SR)	5 Wrought	7 Fiberglass	9 Other (Specify below)
<span style="border: 1px solid black; border-radius: 50%; padding: 2px;">2</span> PVC	4 ABS	6 Asbestos-Cement	8 Concrete Tile	

Blank casing diameter 4 in. Was casing pulled? Yes  X No If yes, how much 3'  
 Casing height above or below land surface 36 in.

6 GROUT PLUG MATERIAL: 1 Neat cement 2 Cement grout 3 Bentonite 4 Other Cement

Grout Plug Intervals: From 97 ft. to 1 ft., From 1 ft. to 0 ft., From to ft.

What is the nearest source of possible contamination:

1 Septic tank	6 Seepage pit	11 Fuel storage	<span style="border: 1px solid black; border-radius: 50%; padding: 2px;">16</span> Other (specify below)
2 Sewer lines	7 Pit privy	12 Fertilizer storage	Grain Elevator
3 Watertight sewer lines	8 Sewage lagoon	13 Insecticide storage	
4 Lateral lines	9 Feedyard	14 Abandoned water well	
5 Cess pool	10 Livestock pens	15 Oil well/Gas well	

Direction from well? 999 How many feet? 999

FROM	TO	PLUGGING MATERIALS
97'	1'	Bentonite
1'	0"	Cement

MWC-2

7 CONTRACTOR'S OF LANDOWNER'S CERTIFICATION: This water well was plugged under my jurisdiction and was completed on (mo/day/year) 09-10-07 and this record is true to the best of my knowledge and belief. Kansas Water Well Contractor's License No. 665 This Water Well Record was completed on (mo/day/year) 10-11-07 under the business name of Pratt Well Environmental by (signature) *Steven Egell*

INSTRUCTIONS: Use typewriter or ball point pen. Please press firmly and print clearly. Please fill in blanks, underline or circle the correct answers. Send top three copies to Kansas Department of Health and Environment, Bureau of Water, Geology Section, 1 000 SW Jackson St., Ste. 420, Topeka, Kansas 66612-1367. Telephone: 785/296-5522. Send one to Water Well Owner and retain one for your records.