

**WATER WELL PLUGGING RECORD Form WWC-5P KSA 82a-1212 ID NO.**


N/A

**1 LOCATION OF WATER WELL:** Fraction 1/4 1/4 1/4 SW 1/4 Section Number 31 Township Number T 28 S Range Number 39  E  W  
 County: STANTON

Street/Rural Address of Well Location; if unknown, distance & direction from nearest town or intersection: If at owner's address, check here  Approx. 4 miles west, 1/2 mile south,  
200' east of Big Bow Grade

**2 WATER WELL OWNER:** Eva Howry  
 RR#, St. Address, Box #: 419 Nth Harmon  
 City, State ZIP Code: Watonga Ok., 73772

**Global Positioning Systems (GPS) information:**  
 Latitude: 37.56493 N (in decimal degrees)  
 Longitude: 101.63483 W (in decimal degrees)  
 Elevation: \_\_\_\_\_  
 Datum:  WGS84,  NAD83,  NAD27  
 Collection Method: \_\_\_\_\_  
 GPS unit (Make/Model: Magellan eXplorist GC)  
 Digital Map/Photo,  Topographic Map,  Land Survey  
 Est. Accuracy:  < 3 m,  3-5 m,  5-15 m,  > 15 m

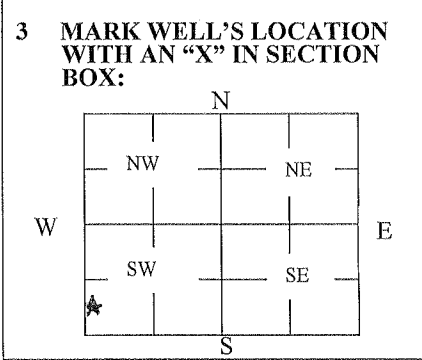

**4 DEPTH OF WELL** 355' ft.  
 WELL'S STATIC WATER LEVEL 320' ft.  
 WELL WAS USED AS:  
 Domestic Irrigation  Public Water Supply  Dewatering  
 Feedlot  Oil Field Water Supply  Monitoring  
 Industrial  Domestic (Lawn & Garden)  Injection Well  
 Air Conditioning  Other \_\_\_\_\_  
 Was a chemical/bacteriological sample submitted to Department? Yes  No

**5 TYPE OF BLANK CASING USED:**  
 Steel  RMP (SR)  Wrought  Fiberglass  Other (Specify below) \_\_\_\_\_  
 PVC  ABS  Asbestos-Cement  Concrete Tile  
 Blank casing diameter 16" in. Was casing pulled? Yes  No  If yes, how much 60"  
 Casing height above or below land surface Below 60" in.

**6 GROUT PLUG MATERIAL:**  Neat cement  Cement grout  Bentonite  Other \_\_\_\_\_  
 Grout Plug Intervals: From 10' ft. to 5' ft., From \_\_\_\_\_ ft. to \_\_\_\_\_ ft., From \_\_\_\_\_ to \_\_\_\_\_ ft.  
 What is the nearest source of possible contamination:  
 Septic tank  Seepage pit  Fuel Storage  Other (specify below) \_\_\_\_\_  
 Sewer lines  Pit privy  Fertilizer storage  None Observed  
 Watertight sewer lines  Sewage lagoon  Insecticide storage  
 Lateral lines  Feedyard  Abandoned water well Direction from well? \_\_\_\_\_  
 Cess pool  Livestock pens  Oil well/Gas well How many feet? \_\_\_\_\_

FROM	TO	PLUGGING MATERIALS	FROM	TO	PLUGGING MATERIALS
355'	320'	Chlorinated Road Sand	320'	10'	Oversized rock w/clay chunks
10'	5'	3,000 PSI Concrete	5'	0'	Cut off casing and backfilled

**7 CONTRACTOR'S OR LANDOWNER'S CERTIFICATION:** This water well was plugged under my jurisdiction and was completed on (mo/day/year) 3/12/2013 and this record is true to the best of my knowledge and belief. Kansas Water Well Contractor's License No. 145. This Water Well Record was completed on (mo/day/year) 4/4/2013 under the business name of Hydro Resources Mid Continent by (signature) Gary Clepper

**INSTRUCTIONS:** Use typewriter or ballpoint pen. Please press firmly and print clearly. Please fill in blanks, underline or circle the correct answers. Send top three copies to Kansas Department of Health and Environment, Bureau of Water, Geology Section, 1000 SW Jackson St., Ste. 420, Topeka, Kansas 66612-1367. Telephone: 785/296-5524. Send one to Water Well Owner and retain one for your records. Visit us at <http://www.kdheks.gov/waterwell/index.html>.

Check one:  White Copy  Blue Copy  Pink Copy