

USE TYPEWRITER OR BALL POINT PEN—PRESS FIRMLY, PRINT CLEARLY.

T R EW sec 1/4 1/4 1/4 No.

WATER WELL RECORD
KSA 82a-1201-1215


Kansas State Dept. Of Health
(Water Well Contractors)
Forbes-Bldg. 740
Topeka, Kansas 66620

1 Location of well:	County Stanton	Township name Stanton	Fraction SW SW NE	Section number 5	Town number T28 S	Range number R39 W
---------------------	--------------------------	---------------------------------	-----------------------------	----------------------------	-----------------------------	------------------------------

Distance and direction from nearest town or city: **5 1/2 miles N. 2W of Big Bow, Kansas**

3 Owner of well: **O. W. Josserand Johnson, Kansas 67855**

Street address of well location if in city: _____ Address: _____

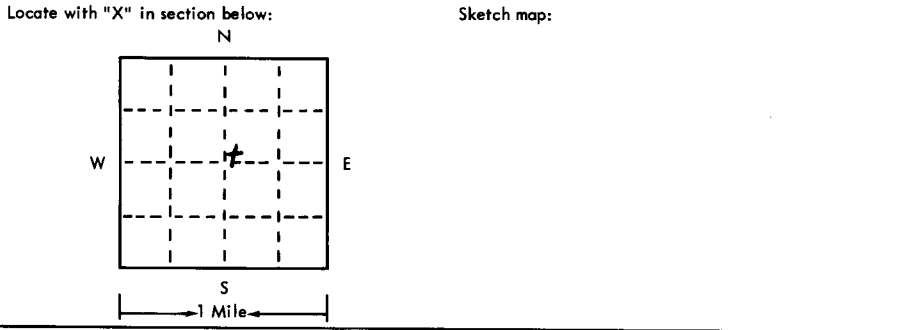

4 Well depth: **612** ft. Date of completion **2/24/75**
Well diameter **27** in.

5 Cable tool Rotary Driven Dug
 Hollow rod Jetted Bored Reverse rotary

6 Use: Domestic Public supply Industry
 Irrigation Air conditioning Commercial
 Test well

7 Casing: Material **steel** Height: **above** below
Threaded Welded Surface **10** in.
Diam. **16"** Weight **42.05** lbs./ft. **16** in. to **28** ft. depth Drive shoe? Yes No
_____ in. to _____ ft. depth

2	Type and color of material	From	To
	Surface Clay	0	2
	Fine sand w/clay breakers	45	90
	Gray clay	90	107
	Brown clay	107	170
	Blue clay	170	226
	Fine to medium sand small clay breakers	226	260
	Sandy clay	260	310
	Sandy clay, lime, small sand strips	310	341
	Yellow chalk & sandrock, fair	341	356
	Yellow and blue shale with sandstone	356	390
	Blue shale and sandrock,	390	415
	Blue shale, very small sandstone strips	415	495
	Blue shale & sandstone (takes water)	495	535
	Blue shale & Cheyenne sandstone	535	550
	Blue & brown shale, small sandstone strips	550	580
	Shale & sandstone (takes water)	580	611
	Shale and rock small sandstone strips	611	612
	(use a second sheet if needed)		

8 Screen: Manufacturer **Lakewood Per S:**
Type **steel** Dia. **16"**
Slot/gauze **3/16** Length **2"** (304 feet) Per
Set between **228** ft. and **408** ft. Blank **408-488**
Packs: **488-612** 1/4 x 5/8
Gravel pack Yes No Size range of material _____

9 Static water level: **101.6** ft. below land surface Date **3-6-75**

10 Pumping level below land surfaces:
310 ft. after **105** hrs. pumping **740** g.p.m.
_____ ft. after _____ hrs. pumping _____ g.p.m.
Estimated maximum yield **1000** g.p.m.

11 Water sample submitted:
 Yes No Date _____

12 Well head completion:
 Pitless adapter **2** inches above grade

13 Well grouted? Yes No
 Neat cement Bentonite _____
Depth: From **0** ft. to **10** ft.

14 Nearest source of possible contamination:
ft. _____ Direction **2 miles W** Type **house**
Well disinfected upon completion? Yes No

15 Pump: Not installed
Manufacturer's name _____
Model number _____ HP _____ Volts _____
Length of drop pipe _____ ft. capacity _____ g.p.m.
Type:
 Submersible Turbine
 Jet Reciprocating
 Centrifugal Other

16 Remarks: elevation **Wheat field**

Topography:
 Hill
 Slope
 Upland
 Valley

17 Water well contractor's certification:
This well was drilled under my jurisdiction and this report is true to the best of my knowledge and belief.
Houck Bros. Drlg. Co. 164
Business name _____ License No. _____
Address **Box 487, Ulysses, Ks.**
Signed **M. Beard** Date **3-28-75**
Authorized representative