USE TYPEWRITER OR BALL POINT PEN-PRESS FIRMLY, PRINT CLEARLY.

WATER WELL RECORD
KSA 82a-1201-1215

Kansas Department of Health and Environment-Division of Environment
(Water well Contractors)
Topeka, Kansas 66620

1. Location of well:	County	Fraction	Section number	Township number	Range number
	Stanton	NW 1/4 NW 1/4 SE 1/4	18	T 28 S	R 39 E (W)

2. Distance and direction from nearest town or city:
3½ W. & 3½ N. of Big Bow
Street address of well location if in city:

3. Owner of well: A. C. Anderson
R.R. or street:
City, state, zip code: Johnson, KS 67855

4. Locate with "X" in section below:

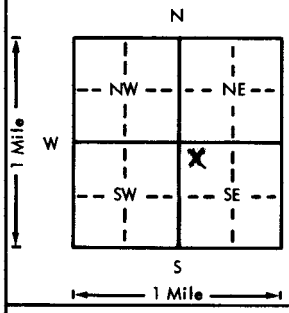

Sketch map:

Well drilled 4-9-76

6. Bore hole dia. 26 in. Completion date 4-16-76
Well depth 637 ft.

7. __ Cable tool __ Rotary __ Driven __ Dug
__ Hollow rod __ Jetted __ Bored X Reverse rotary

8. Use: __ Domestic __ Public supply __ Industry
X Irrigation __ Air conditioning __ Stock
__ Lawn __ Oil field water __ Other

9. Casing: Material Steel Height (Above) or below
Threaded __ Welded X Surface 12 in.
RMP __ PVC __ Weight 42 lbs./ft.
Dia. 16 in. to 637 ft. depth Wall Thickness: inches or
Dia. __ in. to __ ft. depth gage No. .250

5. Type and color of material	From	To
See attachment		

(Use a second sheet if needed)

10. Screen: Manufacturer's name Johnson
Type Continuous Dia. 16"
Slot/gauze 60 & .150 Length 200'
Set between 257 & 267 ft. and 290 & 320 ft.
337 & 352 ft. and 385 & 395 ft.
Gravel pack? yes Size range of material 1/8 x 1/4

11. Static water level: mo./day/yr.
176 ft. below land surface Date 4-16-76

12. Pumping level below land surfaces:
269 ft. after ___ hrs. pumping 1060 g.p.m.
___ ft. after ___ hrs. pumping ___ g.p.m.
Estimated maximum yield ___ g.p.m.

13. Water sample submitted: mo./day/yr.
__ Yes X No Date ___

14. Well head completion:
__ Pitless adapter 12 Inches above grade

15. Well grouted? Yes
With: __ Neat cement X Bentonite __ Concrete
Depth: From 0 ft. to 10 ft.

16. Nearest source of possible contamination: None observed
ft. ___ Direction ___ Type ___
Well disinfected upon completion? ___ Yes X No

17. Pump: X Not installed
Manufacturer's name ___
Model number ___ HP ___ Volts ___
Length of drop pipe ___ ft. capacity ___ g.p.m.
Type:
__ Submersible __ Turbine
__ Jet __ Reciprocating
__ Centrifugal __ Other

18. Elevation: Flat
Topography:
__ Hill
__ Slope
__ Upland
__ Valley

19. Remarks:

20. Water well contractor's certification:
This well was drilled under my jurisdiction and this report is true to the best of my knowledge and belief.
Henkle Drilling & Supply 145
Business name License No.
Address Box 639, Garden City, KS
Signed [signature] Date 5-5-76
Authorized representative

480 & 495'
514 & 634'

T 28 S
R 39 E (W)
Sec 18
NW 1/4 NW 1/4 SE 1/4

Forward the white, blue and pink copies to the Department of Health and Environment

Form WWC-5

DRILLERS TEST LOG

CUSTOMERS NAME A. C. Anderson DATE 12-22-75
STREET ADDRESS TEST # 6 E.L.
CITY & STATE Johnson Kansas DRILLER Livingston
COUNTY Stanton QUARTER SE SECTION 18 TOWNSHIP 28 RANGE 39

LOCATION 50' SE of Old Well
4" Gasline 75' E 4" Gas Line 35' N

Well Location

%	DRILLED From	Pay	FOOTAGE To	Description of Strata — Static Water Level — Proposed Well Depth
	0		2	Top soil
	2		60	Brown clay caliche
	60		67	Sand fine to med & few clay st
	67		200	Brown clay & limerock ledges & few fine sand st.
65	200	28	228	Sand fine to med coarse small gravel & tan rock loose, very few clay st & rock ledges
	228		250	Brown clay & few fine sand st.
60	250	17	267	Sand fine to med coarse small gravel & tan & white rock few rock ledges & clay st
	267		290	Brown clay & few rock ledges & sand st.
50	290	15	305	Sand fine to med coarse & few clay st.
35	305	17	322	Sand fine to med, few coarse & clay st.
	322		336	Brown sandy clay limerock ledges
60	336	17	353	Sand fine to med coarse small brown gravel
	353		380	Brown clay, sticky
15	380	13	393	Brown sandy clay & sand fine to med st.
	393		416	Brown sandy clay & limerock ledges & few sand st
	416		452	Brown & yellow clay, sticky
	452		480	Weathered shale
Good	480	14	494	Dakota & soapstone
	494		520	Shale, soapstone & dakota st
Fair	520	20	540	Soapstone & dakota
Very Good	540	94	634	Dakota & soapstone, used lots of water loose, in places cheyenne
	634		650	Brown shale, limestone
	650		655	Red bed

total Depth of well 637'