USE TYPEWRITER OR BALL POINT PEN-PRESS FIRMLY, PRINT CLEARLY.

WATER WELL RECORD
KSA 82a-1201-1215

Kansas Department of Health and Environment-Division of Environment
(Water well Contractors)
Topeka, Kansas 66620

1. Location of well:	County	Fraction	Section number	Township number	Range number
	Stanton	SE 1/4 SE 1/4 Se 1/4	34	T 28 S	R 39 E (W)

2. Distance and direction from nearest town or city:
Location at Big Bow Elevator
Street address of well location if in city:

3. Owner of well: Jake Broyles
R.R. or street: Big, Bow, Ks. 67832
City, state, zip code:

4. Locate with "X" in section below: Sketch map:

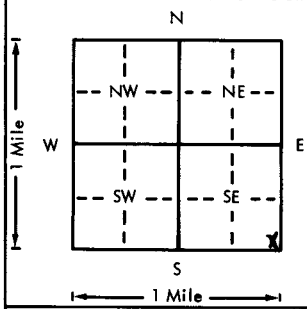

6. Bore hole dia. 9 1/4 in. Completion date
Well depth 310 ft. 6/28/77

7. __ Cable tool X Rotary __ Driven __ Dug
__ Hollow rod __ Jetted __ Bored __ Reverse rotary

8. Use: X Domestic __ Public supply __ Industry
__ Irrigation __ Air conditioning __ Stock
__ Lawn __ Oil field water __ Other

9. Casing: Material styrene Weight: Above or below
Threaded glued Welded __ Surface 14 in.
RMP __ PVC __ Weight __ lbs./ft.
Dia. 5" in. to 270 ft. depth Wall Thickness: inches or
Dia. __ in. to __ ft. depth gage No. .320

5. Type and color of material	From	To
Surface	0	2
Sandy clay	2	65
Fine sand w/clay breakers	65	160
Sandy clay	160	237
Fine to medium sand w/clay strips	237	315

(Use a second sheet if needed)

10. Screen: Manufacturer's name ~~Sf/~~ Sunflower
Type styrene Dia. 5"
Slot/gauze 1/16" Length 40'
Set between 270 ft. and 310 ft.
__ ft. and __ ft.
Gravel pack? X Size range of material 1/4"

11. Static water level: mo./day/yr.
143 ft. below land surface Date 3/27/77

12. Pumping level below land surfaces:
186 ft. after 18 hrs. pumping 15 g.p.m.
__ ft. after __ hrs. pumping __ g.p.m.
Estimated maximum yield 30 g.p.m.

13. Water sample submitted: mo./day/yr.
__ Yes __ No X Date

14. Well head completion:
X Pitless adapter 24 Inches above grade

15. Well grouted? X
With: X Neat cement __ Bentonite __ Concrete
Depth: From 0 ft. to 10 ft.

16. Nearest source of possible contamination:
ft. 100 Direction west Type septic tank
Well disinfected upon completion? X Yes __ No

17. Pump: X Not installed
Manufacturer's name
Model number HP Volts
Length of drop pipe ft. capacity g.p.m.
Type:
__ Submersible __ Turbine
__ Jet __ Reciprocating
__ Centrifugal __ Other

18. Elevation:
Topography:
__ Hill
X Slope
__ Upland
__ Valley

19. Remarks:

20. Water well contractor's certification:
This well was drilled under my jurisdiction and this report is true to the best of my knowledge and belief.
Houck Bros. Drilling Co., Inc 164
Business name License No.
Address Bos 487, Ulysses, Ks.
Signed M. Beard Date 7/19/77
Authorized representative

28 T 39 R (W) E 34 Sec SESE 1/4 1/4 1/4 1/4

Forward the white, blue and pink copies to the Department of Health and Environment

Form WWC-5