

USE TYPEWRITER OR BALL POINT PEN-PRESS FIRMLY, PRINT CLEARLY.

WATER WELL RECORD
KSA 82a-1201-1215


Kansas Department of Health and Environment-Division of Environment (Water well Contractors) Topeka, Kansas 66620

SW 1/4 SW SW

1. Location of well: County **Stanton** Fraction **Lot 1, Block 6 City of Big Bow** Section number **35** Township number **28** Range number **39** (W)

2. Distance and direction from nearest town or city: Street address of well location if in city: **no street names**

3. Owner of well: **Morris Whitcomb**
R.R. or street: **Big Bow, Ks. 67832**
City, state, zip code:

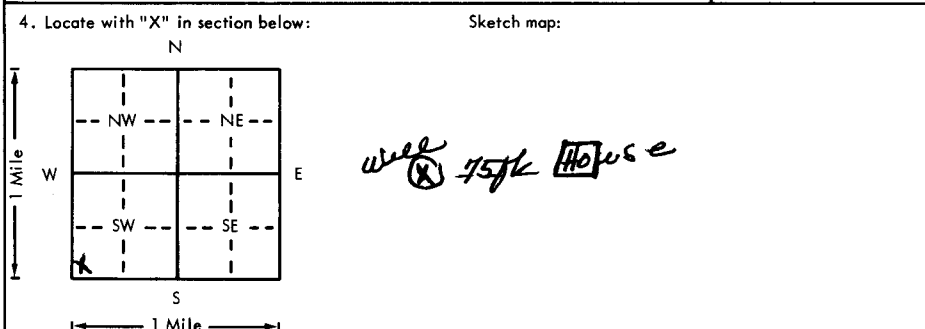

6. Bore hole dia. 9 1/2 in. Completion date 9-28-78
Well depth 296 ft.

7. Cable tool Rotary Driven Dug
 Hollow rod Jetted Bored Reverse rotary

8. Use: Domestic Public supply Industry
 Irrigation Air conditioning Stock
 Lawn Oil field water Other

9. Casing: Material styrene Height 12 ft. or below
 Threaded Welded Surface in.
RMP _____ PVC _____ Weight _____ lbs./ft.
Dia. 5 in. to 266 ft. depth Wall Thickness: inches or
Dia. _____ in. to _____ ft. depth gage No. .520

5. Type and color of material	From	To
Surface	0	2
Clay w/fine sandstrips	2	45
Sandy clay	45	85
Medium sand XXXXXX	85	105
Sandy clay	105	175
Fine to medium sand	175	190
Sandy clay w/fine sand strips	190	275
Medium sand w/fine sand strips	275	297
Sandy clay w/fine sand strips	297	330
(Use a second sheet if needed)		

10. Screen: Manufacturer's name Sunflower
Type styrene Dia. 5"
Slot/gauze 1/16 Length 30
Set between 266 ft. and 296 ft.
_____ ft. and _____ ft.
Gravel pack? Size range of material _____

11. Static water level: _____ mo./day/yr.
143 ft. below land surface Date 10-2-78

12. Pumping level below land surfaces:
186 ft. after 16 hrs. pumping 15 g.p.m.
_____ ft. after _____ hrs. pumping _____ g.p.m.
Estimated maximum yield 30 g.p.m.

13. Water sample submitted: _____ mo./day/yr.
Yes No Date _____

14. Well head completion:
 Pitless adapter 12 Inches above grade

15. Well grouted?
With: Neat cement _____ Bentonite _____ Concrete _____
Depth: From 0 ft. to 10 ft.

16. Nearest source of possible contamination:
ft. 120 Direction north Type Septic tank
Well disinfected upon completion? Yes No

17. Pump: Not installed
Manufacturer's name _____
Model number _____ HP _____ Volts _____
Length of drop pipe _____ ft. capacity _____ g.p.m.
Type:
 Submersible Turbine
 Jet Reciprocating
 Centrifugal Other

18. Elevation: _____

19. Remarks: _____

Topography:
 Hill
 Slope
 Upland
 Valley

20. Water well contractor's certification:
This well was drilled under my jurisdiction and this report is true to the best of my knowledge and belief.
Houck Bros. Drlg. Co. 164
Business name License No. _____
Address **Box 487, Ulysses, Ks.**
Signed M. Beard Date 10/20/78
Authorized representative

28
 39
 35
 1/4
 1/4
 1/4
 1/4
 SW SW SW