


**WATER WELL RECORD Form WWC-5 KSA 82a-1212**

<b>1 LOCATION OF WATER WELL:</b>	Fraction	Section Number	Township Number	Range Number
County: <b>Stanton</b>	<b>SE 1/4 SW 1/4 SW 1/4</b>	<b>35</b>	<b>T 28 S</b>	<b>R 39 E/W</b>

Distance and direction from nearest town or city street address of well if located within city?  
**Big Bow**

**2 WATER WELL OWNER:** **Johnson Co-op Grain**  
 RR#, St. Address, Box # : **304 E. Highland**  
 City, State, ZIP Code : **Johnson, Ks. 67855** #4  
 Board of Agriculture, Division of Water Resources  
 Application Number:

**3 LOCATE WELL'S LOCATION WITH AN "X" IN SECTION BOX:**

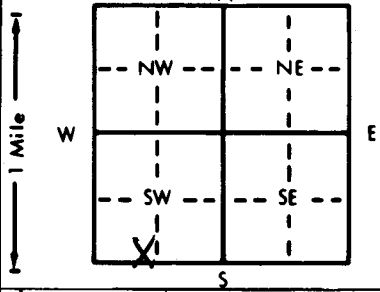

**4 DEPTH OF COMPLETED WELL:** **138** ft. **ELEVATION:** \_\_\_\_\_ ft.  
 Depth(s) Groundwater Encountered 1. \_\_\_\_\_ ft. 2. \_\_\_\_\_ ft. 3. \_\_\_\_\_ ft.  
**WELL'S STATIC WATER LEVEL** **108.10** ft. below land surface measured on mo/day/yr \_\_\_\_\_  
 Pump test data: Well water was \_\_\_\_\_ ft. after \_\_\_\_\_ hours pumping \_\_\_\_\_ gpm  
 Est. Yield \_\_\_\_\_ gpm: Well water was \_\_\_\_\_ ft. after \_\_\_\_\_ hours pumping \_\_\_\_\_ gpm  
 Bore Hole Diameter \_\_\_\_\_ in. to \_\_\_\_\_ ft., and \_\_\_\_\_ in. to \_\_\_\_\_ ft.  
**WELL WATER TO BE USED AS:** 5 Public water supply 8 Air conditioning 11 Injection well  
 1 Domestic 3 Feedlot 6 Oil field water supply 9 Dewatering 12 Other (Specify below)  
 2 Irrigation 4 Industrial 7 Lawn and garden only 10 Monitoring well \_\_\_\_\_  
 Was a chemical/bacteriological sample submitted to Department? Yes \_\_\_\_\_ No **X** \_\_\_\_\_; If yes, mo/day/yr sample was submitted  
 Water Well Disinfected? Yes \_\_\_\_\_ No **X** \_\_\_\_\_

**5 TYPE OF BLANK CASING USED:**

1 Steel	3 RMP (SR)	5 Wrought iron	8 Concrete tile	CASING JOINTS: Glued _____ Clamped _____
2 PVC	4 ABS	6 Asbestos-Cement	9 Other (specify below)	Welded _____
		7 Fiberglass		Threaded _____

Blank casing diameter **4** in. to **110** ft., Dia \_\_\_\_\_ in. to \_\_\_\_\_ ft., Dia \_\_\_\_\_ in. to \_\_\_\_\_ ft.  
 Casing height above land surface \_\_\_\_\_ in., weight **2.071** lbs./ft. Wall thickness or gauge No. **237**  
**TYPE OF SCREEN OR PERFORATION MATERIAL:**

1 Steel	3 Stainless steel	5 Fiberglass	8 RMP (SR)	10 Asbestos-cement
2 Brass	4 Galvanized steel	6 Concrete tile	9 ABS	11 Other (specify) _____
				12 None used (open hole)

**SCREEN OR PERFORATION OPENINGS ARE:**

1 Continuous slot	3 Mill slot	5 Gauzed wrapped	8 Saw cut	11 None (open hole)
2 Louvered shutter	4 Key punched	6 Wire wrapped	9 Drilled holes	
		7 Torch cut	10 Other (specify) _____	

**SCREEN-PERFORATED INTERVALS:** From **110** ft. to **138** ft., From \_\_\_\_\_ ft. to \_\_\_\_\_ ft.  
 From \_\_\_\_\_ ft. to \_\_\_\_\_ ft., From \_\_\_\_\_ ft. to \_\_\_\_\_ ft.  
**GRAVEL PACK INTERVALS:** From \_\_\_\_\_ ft. to \_\_\_\_\_ ft., From \_\_\_\_\_ ft. to \_\_\_\_\_ ft.  
 From \_\_\_\_\_ ft. to \_\_\_\_\_ ft., From \_\_\_\_\_ ft. to \_\_\_\_\_ ft.

**6 GROUT MATERIAL:** 1 Neat cement 2 Cement grout 3 Bentonite 4 Other \_\_\_\_\_  
 Grout Intervals: From **0** ft. to **2** ft., From **2** ft. to **80** ft., From \_\_\_\_\_ ft. to \_\_\_\_\_ ft.  
 What is the nearest source of possible contamination:  
 1 Septic tank 4 Lateral lines 7 Pit privy 10 Livestock pens 14 Abandoned water well  
 2 Sewer lines 5 Cess pool 8 Sewage lagoon 11 Fuel storage 15 Oil well/Gas well  
 3 Watertight sewer lines 6 Seepage pit 9 Feedyard 12 Fertilizer storage 16 Other (specify below)  
 13 Insecticide storage **Fuel Storage Removal**  
 Direction from well? \_\_\_\_\_ How many feet? \_\_\_\_\_

FROM	TO	LITHOLOGIC LOG	FROM	TO	PLUGGING INTERVALS
0	2	Surface			
2	12	Loess			
12	31	Clay w/Caliche Strks.			
31	62	Sandy Clay w/Caliche Strks.			
62	65	Sand			
65	69	Sandy Clay, Caliche & Sand St.			
69	77	Sand w/Clay Strks.			
77	82	Sandy Clay			
82	90	Fine Sand w/Clay Strks.			
90	110	Sandy Clay w/some Caliche			
110	114	Fine Sand w/Clay Strks.			
114	120	Sandy Clay w/Fine Sand Strks.			
120	134	Sandy Clau w/Caliche Strks.			
134	135	Caliche			
135	138	Clay w/Caliche Strks. & Sand Strks.			

**7 CONTRACTOR'S OR LANDOWNER'S CERTIFICATION:** This water well was (1) constructed, (2) reconstructed, or (3) plugged under my jurisdiction and was completed on (mo/day/year) **1-17-94** and this record is true to the best of my knowledge and belief. Kansas Water Well Contractor's License No. **554** This Water Well Record was completed on (mo/day/yr) **5-30-94** under the business name of **Woofter Pump & Well, Inc.** by (signature) *July C. Woofter*

INSTRUCTIONS: Use typewriter or ball point pen. PLEASE PRESS FIRMLY and PRINT clearly. Please fill in blanks, underline or circle the correct answers. Send three copies to Kansas Department of Health and Environment, Bureau of Water, Topeka, Kansas 66620-0001. Telephone: 913-296-5545. Send one to WATER WELL OWNER and retain one for your records.