


1 LOCATION OF WATER WELL: Fraction SE 1/4 SW 1/4 SW 1/4 Section Number 35 Township Number T 28 S Range Number R 39 E/W  
 County: Stanton  
 Distance and direction from nearest town or city street address of well if located within city?

2 WATER WELL OWNER: Johnson Co-op Grain  
 RR#, St. Address, Box #: 304 E. Highland Board of Agriculture, Division of Water Resources  
 City, State, ZIP Code: Johnson, Ks. 67855-Big Bow SB-9 MWH 3 Application Number:

3 LOCATE WELL'S LOCATION WITH AN "X" IN SECTION BOX:

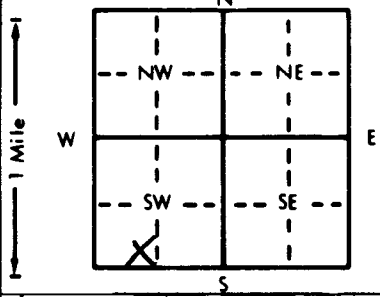

4 DEPTH OF COMPLETED WELL: 125 ft. ELEVATION: .....  
 Depth(s) Groundwater Encountered 1. .... ft. 2. .... ft. 3. .... ft.  
 WELL'S STATIC WATER LEVEL 119.3 ft. below land surface measured on mo/day/yr .....  
 Pump test data: Well water was ..... ft. after ..... hours pumping ..... gpm  
 Est. Yield ..... gpm: Well water was ..... ft. after ..... hours pumping ..... gpm  
 Bore Hole Diameter ..... in. to ..... ft., and ..... in. to ..... ft.  
 WELL WATER TO BE USED AS: 5 Public water supply 8 Air conditioning 11 Injection well  
 1 Domestic 3 Feedlot 6 Oil field water supply 9 Dewatering 12 Other (Specify below)  
 2 Irrigation 4 Industrial 7 Lawn and garden only 10 Monitoring well .....  
 Was a chemical/bacteriological sample submitted to Department? Yes.....No...X.....; If yes, mo/day/yr sample was submitted  
 Water Well Disinfected? Yes No X

5 TYPE OF BLANK CASING USED: 5 Wrought iron 8 Concrete tile CASING JOINTS: Glued ..... Clamped .....  
 1 Steel 3 RMP (SR) 6 Asbestos-Cement 9 Other (specify below) Welded .....  
 2 PVC 4 ABS 7 Fiberglass ..... Threaded... X .....  
 Blank casing diameter ..... in. to 95 ft., Dia ..... in. to ..... ft., Dia ..... in. to ..... ft.  
 Casing height above land surface ..... in., weight ..... lbs./ft. Wall thickness or gauge No. ....  
 TYPE OF SCREEN OR PERFORATION MATERIAL: 7 PVC 10 Asbestos-cement  
 1 Steel 3 Stainless steel 5 Fiberglass 8 RMP (SR) 11 Other (specify) .....  
 2 Brass 4 Galvanized steel 6 Concrete tile 9 ABS 12 None used (open hole)  
 SCREEN OR PERFORATION OPENINGS ARE: 5 Gauzed wrapped 8 Saw cut 11 None (open hole)  
 1 Continuous slot 3 Mill slot 6 Wire wrapped 9 Drilled holes  
 2 Louvered shutter 4 Key punched 7 Torch cut 10 Other (specify) .....  
 SCREEN-PERFORATED INTERVALS: From ..... 95 ft. to ..... 125 ft., From ..... ft. to ..... ft.  
 From ..... ft. to ..... ft., From ..... ft. to ..... ft.  
 GRAVEL PACK INTERVALS: From ..... 70 ft. to ..... 125 ft., From ..... ft. to ..... ft.  
 From ..... ft. to ..... ft., From ..... ft. to ..... ft.

6 GROUT MATERIAL: 1 Neat cement 2 Cement grout 3 Bentonite 4 Other .....  
 Grout Intervals: From ..... 0 ft. to ..... 2 ft., From ..... 2 ft. to ..... 70 ft., From ..... ft. to ..... ft.  
 What is the nearest source of possible contamination: 3 10 Livestock pens 14 Abandoned water well  
 1 Septic tank 4 Lateral lines 7 Pit privy 11 Fuel storage 15 Oil well/Gas well  
 2 Sewer lines 5 Cess pool 8 Sewage lagoon 12 Fertilizer storage 16 Other (specify below)  
 3 Watertight sewer lines 6 Seepage pit 9 Feedyard 13 Insecticide storage Removed Fuel Storage  
 Direction from well? How many feet?

FROM	TO	LITHOLOGIC LOG	FROM	TO	PLUGGING INTERVALS
0	2	Surface	112	125	Sticky Sandy Clay w/Some Fine Sand
2	5	Drk. Brn. Clay /Slightly Silty			
5	10	Clay			
10	20	Brn. Clay/Slightly Silty			
20	26	Clay w/some Caliche			
26	31	Clay, Sand Mixed w/Clay & Caliche Strks.			
31	38	Slightly Silty to Sandy Clay			
38	48	Clay w/Caliche			
48	63	Clay & Caliche Strks.			
63	72	Fine Sand & Clay Strks.			
72	75	Sandy Clay /Caliche & Fine Sand Strks.			
75	81	Sandy Clay & Caliche Strks.w/Fine Sand			
81	83	Clay			
83	103	Sand & Clay Strks.			
103	112	Sticky Sandy Clay			

7 CONTRACTOR'S OR LANDOWNER'S CERTIFICATION: This water well was (1) constructed, (2) reconstructed, or (3) plugged under my jurisdiction and was completed on (mo/day/year) ..... 1-20-94 ..... and this record is true to the best of my knowledge and belief. Kansas Water Well Contractor's License No. .... 554 ..... This Water Well Record was completed on (mo/day/yr) ... 5-30-94 ... under the business name of Woofter Pump & Well, Inc. by (signature) Guy C. Woofter