


1 LOCATION OF WATER WELL: County: <u>Sedawick</u>	Fraction <u>SE</u> $\frac{1}{4}$ <u>NW</u> $\frac{1}{4}$ <u>NW</u> $\frac{1}{4}$	Section Number <u>16</u>	Township Number T <u>28</u> S	Range Number R <u>4</u> <u>EW</u>
--	---	-----------------------------	----------------------------------	--------------------------------------

2 F. Cheney

2	WATER WELL OWNER:	Kevin Young	Board of Agriculture, Division of Water Resources Application Number:
RR#, St. Address, Box # :		4125 Freida Rd.	
City, State, ZIP Code :		Cheney, KS 67025	



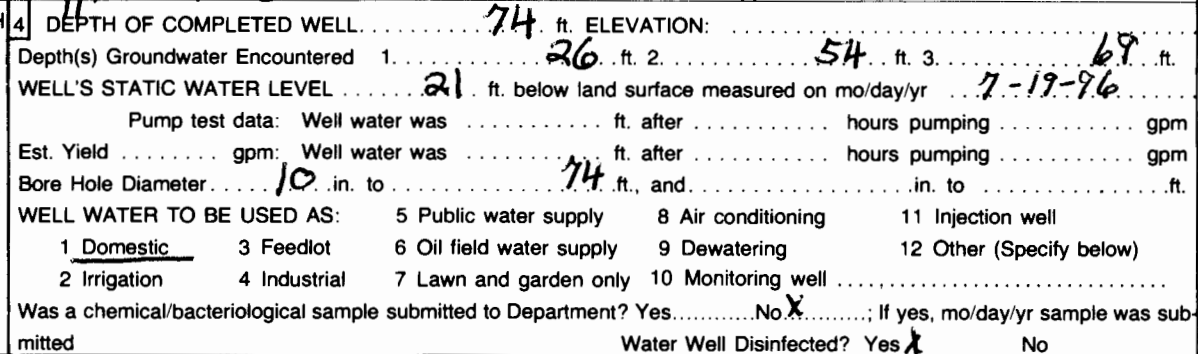

TYPE OF BLANK CASING USED:		5 Wrought iron	8 Concrete tile	CASING JOINTS: <u>Glued</u> Clamped
1 Steel	3 RMP (SR)	6 Asbestos-Cement	9 Other (specify below)	<u>Welded</u>
2 <u>PVC</u>	4 ABS	7 Fiberglass		<u>Threaded</u>
Blank casing diameter <u>5</u> in. to <u>34</u> ft., Dia in. to ft., Dia in. to ft.				
Casing height above land surface <u>18</u> in., weight lbs./ft. Wall thickness or gauge No. <u>SDR 26</u>				
TYPE OF SCREEN OR PERFORATION MATERIAL:		7 <u>PVC</u>	10 Asbestos-cement	
1 Steel	3 Stainless steel	8 RMP (SR)	11 Other (specify)	
2 Brass	4 Galvanized steel	9 ABS	12 None used (open hole)	
SCREEN OR PERFORATION OPENINGS ARE:		5 Gauzed wrapped	8 <u>Saw cut</u>	11 None (open hole)
1 Continuous slot	3 Mill slot	6 Wire wrapped	9 <u>Drilled holes</u>	
2 Louvered shutter	4 Key punched	7 Torch cut	10 Other (specify)	
SCREEN-PERFORATED INTERVALS:		From <u>34</u> ft. to <u>74</u> ft., From ft. to ft.		
		From ft. to ft., From ft. to ft.		
GRAVEL PACK INTERVALS:		From <u>20</u> ft. to <u>74</u> ft., From ft. to ft.		
		From ft. to ft., From ft. to ft.		

6 GROUT MATERIAL: 1 Neat cement 2 Cement grout 3 Bentonite 4 Other Baroid - Hole Plug

Grout Intervals: From 3 ft. to 20 ft. From _____ ft. to _____ ft. From _____ ft. to _____ ft.

What is the nearest source of possible contamination:

1 Septic tank	4 Lateral lines	7 Pit privy	10 Livestock pens	14 Abandoned water well
2 Sewer lines	5 Cess pool	8 <u>Sewage lagoon</u>	11 Fuel storage	15 Oil well/Gas well
3 Watertight sewer lines	6 Seepage pit	9 Feedyard	12 Fertilizer storage	16 Other (specify below)
			13 Insecticide storage	

Direction from well? SE

How many feet? 135

[illegible]

7 CONTRACTOR'S OR LANDOWNER'S CERTIFICATION: This water well was (1) constructed, (2) reconstructed, or (3) plugged under my jurisdiction and was completed on (mo/day/year) 7-19-96 and this record is true to the best of my knowledge and belief. Kansas Water Well Contractor's License No. 395 This Water Well Record was completed on (mo/day/yr) 7-26-96 under the business name of Craig Roberts Co. by (signature) Craig Roberts

INSTRUCTIONS: Use typewriter or ball point pen. PLEASE PRESS FIRMLY and PRINT clearly. Please fill in blanks, underline or circle the correct answers. Send to three copies to Kansas Department of Health and Environment, Bureau of Water, Topeka, Kansas 66620-0001. Telephone: 913-296-5545. Send one to WATER WELL OWNER and retain one for your records.