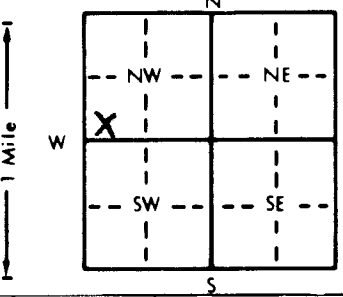


1 LOCATION OF WATER WELL:		Fraction	Section Number	Township Number	Range Number
County: <u>Sedgwick</u>		<u>SW 1/4 SW 1/4 NW 1/4</u>	<u>4</u>	T <u>28</u> S	R <u>4</u> EW
Distance and direction from nearest town or city street address of well if located within city? <u>1/2 N. Cheney</u>					
2 WATER WELL OWNER: <u>Robert Lawrie</u>					
RR#, St. Address, Box #: <u>2662 S. 375 W.</u>					
City, State, ZIP Code: <u>Cheney, KS 67025</u>					
Board of Agriculture, Division of Water Resources Application Number:					
3 LOCATE WELL'S LOCATION WITH AN "X" IN SECTION BOX:		4 DEPTH OF COMPLETED WELL: <u>74</u> ft. ELEVATION:			
		Depth(s) Groundwater Encountered 1. <u>26</u> ft. 2. <u>58</u> ft. 3. <u>70</u> ft.			
		WELL'S STATIC WATER LEVEL <u>25</u> ft. below land surface measured on mo/day/yr <u>12-7-96</u>			
		Pump test data: Well water was _____ ft. after _____ hours pumping _____ gpm			
		Est. Yield _____ gpm: Well water was _____ ft. after _____ hours pumping _____ gpm			
		Bore Hole Diameter: <u>10</u> in. to <u>74</u> ft., and _____ in. to _____ ft.			
		WELL WATER TO BE USED AS:			
		5 Public water supply 8 Air conditioning 11 Injection well			
		1 Domestic 3 Feedlot 6 Oil field water supply 9 Dewatering 12 Other (Specify below)			
		2 Irrigation 4 Industrial 7 Lawn and garden only 10 Monitoring well			
		Was a chemical/bacteriological sample submitted to Department? Yes _____ No <u>X</u> If yes, mo/day/yr sample was submitted _____			
		Water Well Disinfected? Yes <u>X</u> No _____			
5 TYPE OF BLANK CASING USED:					
1 Steel 3 RMP (SR) 5 Wrought iron 8 Concrete tile CASING JOINTS: Glued <u>X</u> Clamped _____					
2 PVC 4 ABS 6 Asbestos-Cement 9 Other (specify below) Welded _____					
7 Fiberglass _____ Threaded _____					
Blank casing diameter <u>5</u> in. to <u>34</u> ft. Dia. _____ in. to _____ ft. Dia. _____ in. to _____ ft.					
Casing height above land surface: <u>18</u> in., weight _____ lbs./ft. Wall thickness or gauge No. <u>SDR26</u>					
TYPE OF SCREEN OR PERFORATION MATERIAL:					
1 Steel 3 Stainless steel 5 Fiberglass 8 RMP (SR) 10 Asbestos-cement					
2 Brass 4 Galvanized steel 6 Concrete tile 9 ABS 11 Other (specify) _____					
12 None used (open hole)					
SCREEN OR PERFORATION OPENINGS ARE:					
1 Continuous slot 5 Gauzed wrapped 8 Saw cut 11 None (open hole)					
2 Louvered shutter 3 Mill slot 6 Wire wrapped 9 Drilled holes					
4 Key punched 7 Torch cut 10 Other (specify) _____					
SCREEN-PERFORATED INTERVALS: From <u>34</u> ft. to <u>74</u> ft. From _____ ft. to _____ ft.					
From _____ ft. to _____ ft. From _____ ft. to _____ ft.					
GRAVEL PACK INTERVALS: From <u>22</u> ft. to <u>74</u> ft. From _____ ft. to _____ ft.					
From _____ ft. to _____ ft. From _____ ft. to _____ ft.					
6 GROUT MATERIAL: 1 Neat cement 2 Cement grout 3 Bentonite 4 Other <u>Bamid-Hole Plug</u>					
Grout Intervals: From <u>3</u> ft. to <u>22</u> ft. From _____ ft. to _____ ft. From _____ ft. to _____ ft.					
What is the nearest source of possible contamination:					
1 Septic tank 4 Lateral lines 7 Pit privy 10 Livestock pens 14 Abandoned water well					
2 Sewer lines 5 Cess pool 8 Sewage lagoon 11 Fuel storage 15 Oil well/Gas well					
3 Watertight sewer lines 6 Seepage pit 9 Feedyard 12 Fertilizer storage 16 Other (specify below) _____					
13 Insecticide storage _____					
Direction from well? <u>S.E.</u> How many feet? <u>150</u>					
LITHOLOGIC LOG					
FROM	TO	LITHOLOGIC LOG		FROM	TO
0	3	Soil			
3	15	Fine Sand			
15	19	Red Clay			
19	65	Red Shale			
65	74	Blue Shale			
PLUGGING INTERVALS					
7 CONTRACTOR'S OR LANDOWNER'S CERTIFICATION: This water well was (1) <u>constructed</u> , (2) reconstructed, or (3) plugged under my jurisdiction and was completed on (mo/day/year) <u>12-7-96</u> and this record is true to the best of my knowledge and belief. Kansas Water Well Contractor's License No. <u>395</u> This Water Well Record was completed on (mo/day/yr) <u>12-7-96</u> under the business name of <u>Craig Roberts Co.</u> by (signature) <u>Craig Roberts</u>					
INSTRUCTIONS: Use typewriter or ball point pen. PLEASE PRESS FIRMLY and PRINT clearly. Please fill in blanks, underline or circle the correct answers. Send top three copies to Kansas Department of Health and Environment, Bureau of Water, Topeka, Kansas 66620-0001. Telephone: 913-296-5545. Send one to WATER WELL OWNER and retain one for your records.					