WATER WELL RECORD Form WWC-5 KSA 82a-1212

1 LOCATION OF WATER WELL: County: SEDGWICK | Fraction: SW ¼ SE ¼ NW ¼ | Section Number: 8 | Township Number: T 28 S | Range Number: R 4 E/W

Distance and direction from nearest town or city street address of well if located within city?
101 SOUTH ADAMS, CHENEY, KS

2 WATER WELL OWNER: CHENEY COOP
RR#, St. Address, Box # : 101 SOUTH ADAMS
City, State, ZIP Code : CHENEY, KS 67025

MW #8
Board of Agriculture, Division of Water Resources
Application Number:

3 LOCATE WELL'S LOCATION WITH AN "X" IN SECTION BOX:

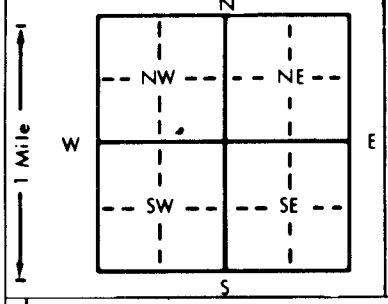

4 DEPTH OF COMPLETED WELL 36 ft. ELEVATION:
Depth(s) Groundwater Encountered 1. 19.79 ft. 2. ft. 3. ft.
WELL'S STATIC WATER LEVEL 19.79 ft. below land surface measured on mo/day/yr 8/24/00
Pump test data: Well water was ft. after hours pumping gpm
Est. Yield 25 gpm: Well water was ft. after hours pumping gpm
Bore Hole Diameter 12¼ in. to 37 ft., and in. to ft.
WELL WATER TO BE USED AS: 1 Domestic 2 Irrigation 3 Feedlot 4 Industrial 5 Public water supply 6 Oil field water supply 7 Lawn and garden only 8 Air conditioning 9 Dewatering 10 Monitoring well 11 Injection well 12 Other (Specify below)
Was a chemical/bacteriological sample submitted to Department? Yes No ✓; If yes, mo/day/yr sample was submitted
Water Well Disinfected? Yes No ✓

5 TYPE OF BLANK CASING USED: 1 Steel 2 PVC 3 RMP (SR) 4 ABS 5 Wrought iron 6 Asbestos-Cement 7 Fiberglass 8 Concrete tile 9 Other (specify below)
CASING JOINTS: Glued ✓ Clamped Welded Threaded
Blank casing diameter 5.625 in. to 26 ft., Dia in. to ft., Dia in. to ft.
Casing height above land surface 24 in., weight 2.79 lbs./ft. Wall thickness or gauge No. SCH 40

TYPE OF SCREEN OR PERFORATION MATERIAL: 7 PVC
1 Steel 2 Brass 3 Stainless steel 4 Galvanized steel 5 Fiberglass 6 Concrete tile 8 RMP (SR) 9 ABS 10 Asbestos-cement 11 Other (specify) 12 None used (open hole)

SCREEN OR PERFORATION OPENINGS ARE: 5 Mill slot
1 Continuous slot 2 Louvered shutter 3 Key punched 4 Key punched 5 Gauzed wrapped 6 Wire wrapped 7 Torch cut 8 Saw cut 9 Drilled holes 10 Other (specify) 11 None (open hole)

SCREEN-PERFORATED INTERVALS: From 26 ft. to 36 ft., From ft. to ft.
From ft. to ft., From ft. to ft.
GRAVEL PACK INTERVALS: From 22.5 ft. to 37 ft., From ft. to ft.
From ft. to ft., From ft. to ft.

6 GROUT MATERIAL: 1 Neat cement 2 Cement grout 3 Bentonite 4 Other
Grout Intervals: From 2 ft. to 22.5 ft., From ft. to ft., From ft. to ft.

What is the nearest source of possible contamination:
1 Septic tank 2 Sewer lines 3 Watertight sewer lines 4 Lateral lines 5 Cess pool 6 Seepage pit 7 Pit privy 8 Sewage lagoon 9 Feedyard 10 Livestock pens 11 Fuel storage 12 Fertilizer storage 13 Insecticide storage 14 Abandoned water well 15 Oil well/Gas well 16 Other (specify below) GRAIN ELEVATOR
Direction from well? 200' NW OF SITE How many feet?

FROM	TO	LITHOLOGIC LOG	FROM	TO	PLUGGING INTERVALS
0	1	TOPSOIL W/MUCH ORGANIC MATTER			
1	3.5	SILT, REDBRN, MUCH CLAY			
3.5	4	SAND, VF-VC, MUCH SILT, REDBRN			
4	9	CLAY, W/MUCH VF SAND, REDBRN			
9	15	SAND VF-VC, RED TAN W/SOME CLAY STREAKS			
15	17	CLAY, REDBRN W/SOME SAND AND MUCH WEATHERED SHALE			
17	23.5	SHALE, REDBRN, HARD, W/ GREEN - GREY INCLUSIONS, FRACTURED			
23.5	24	CLAY, RED-WHITE, SOFT			
24	37	SHALE, RED BRN, W/GREEN - GRAY SHALE STREAKS, HARD			

7 CONTRACTOR'S OR LANDOWNER'S CERTIFICATION: This water well was (1) constructed, (2) reconstructed, or (3) plugged under my jurisdiction and was completed on (mo/day/year) 8/19/00 and this record is true to the best of my knowledge and belief. Kansas Water Well Contractor's License No. 581 This Water Well Record was completed on (mo/day/yr) 9/1/00 under the business name of LAYNE WESTERN, A DIV. OF LAYNE CHRISTENSEN by (signature) Ken McWard

INSTRUCTIONS: Use typewriter or ball point pen. PLEASE PRESS FIRMLY and PRINT clearly. Please fill in blanks, underline or circle the correct answers. Send top three copies to Kansas Department of Health and Environment, Bureau of Water, Topeka, Kansas 66620-0001. Telephone: 913-296-5545. Send one to WATER WELL OWNER and retain one for your records.

OFFICE USE ONLY T R E/W SEC. ¼ ¼ ¼