

1 LOCATION OF WATER WELL:	Fraction	Section Number	Township Number	Range Number
County: Sedgwick	SE $\frac{1}{4}$ SE $\frac{1}{4}$ NW $\frac{1}{4}$	8	T 28 S	R 4 E

Distance and direction from nearest town or city street address of well if located within city?


101 S. Adams, Cheney, Kansas2 WATER WELL OWNER: **Cheney COOP Elevator Association**RR#, St. Address, Box # : **101 S. Adams**

Board of Agriculture, Division of Water Resources

City, State, ZIP Code : **Cheney, Kansas 67025**

Application Number:

3 LOCATE WELL'S LOCATION WITH AN "X" IN SECTION BOX:

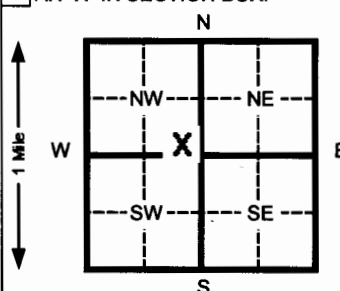

4 DEPTH OF COMPLETED WELL

28.0 ft. ELEVATION:Depth(s) Groundwater Encountered 1 **N/A** ft. 2 _____ ft. 3 _____ ft.WELL'S STATIC WATER LEVEL **19.25** ft. below land surface measured on mo/day/yr **08/13/06**

Pump test data: Well water was _____ ft. after _____ hours pumping _____ gpm

Est. Yield **NA** gpm: Well water was _____ ft. after _____ hours pumping _____ gpmBore Hole Diameter **8.5** in. to **22.0** ft. and **6.5** in. to **30.0** ft.

WELL WATER TO BE USED AS: 5 Public water supply 8 Air conditioning 11 Injection well

1 Domestic 3 Feed lot 6 Oil field water supply 9 Dewatering 12 Other (Specify below)

2 Irrigation 4 Industrial 7 Lawn and garden (domestic) **10 Monitoring well**Was a chemical/bacteriological sample submitted to Department? Yes _____ No **X** If yes, mo/day/yr sample was

submitted

Water Well Disinfected? Yes _____ No **X**

5 TYPE OF BLANK CASING USED:

5 Wrought Iron

8 Concrete tile

CASING JOINTS: Glued _____ Clamped _____

1 Steel

3 RMP (SR)

6 Asbestos-Cement

9 Other (specify below)

Welded _____

2 PVC

4 ABS

7 Fiberglass

Threaded **X**Blank casing diameter **2.375** in. to **8.0** ft., Dia _____ in. to _____ ft., Dia _____ in. to _____ ft.Casing height above land surface **Flush Mount** in., weight _____ lbs./ft. Wall thickness or gauge No. **Schedule 40**

TYPE OF SCREEN OR PERFORATION MATERIAL:

1 Steel

3 Stainless steel

5 Fiberglass

7 PVC

10 Asbestos-cement

2 Brass

4 Galvanized steel

6 Concrete tile

8 RMP (SR)

11 Other (specify)

12 None used (open hole)

SCREEN OR PERFORATION OPENINGS ARE:

1 Continuous slot

3 Mill slot

5 Gauzed wrapped

8 Saw cut

11 None (open hole)

2 Louvered shutter

4 Key punched

6 Wire wrapped

9 Drilled holes

7 Torch cut

10 Other (specify)

SCREEN-PERFORATED INTERVALS:

From **28.0** ft. to **8.0** ft. From _____ ft. to _____ ft.

From _____ ft. to _____ ft. From _____ ft. to _____ ft.

GRAVEL PACK INTERVALS:

From **28.0** ft. to **5.5** ft. From _____ ft. to _____ ft.

From _____ ft. to _____ ft. From _____ ft. to _____ ft.

6 GROUT MATERIAL:

1 Neat cement

2 Cement grout**3** Bentonite

4 Other _____

Grout Intervals From **0.0** ft. to **1.0** ft. From **1.0** ft. to **5.5** ft. From _____ ft. to _____ ft.

What is the nearest source of possible contamination:

1 Septic tank

4 Lateral lines

7 Pit privy

10 Livestock pens

14 Abandoned water well

2 Sewer lines

5 Cess pool

8 Sewage lagoon

11 Fuel storage (former)

15 Oil well/ Gas well

3 Watertight sewer lines

6 Seepage pit

9 Feedyard

12 Fertilizer storage

16 Other (specify below)

13 Insecticide storage

Direction from well?

East

How many feet?

50

FROM TO CODE LITHOLOGIC LOG

0.0	1.0		Black silt, dry
1.0	18.0		Red-brown sand, fine grained, well sorted, dry, odor
18.0	30.0		Red-brown shale, very hard to extremely hard, dry, odor

Flush-mount well completion waiver approved by D. Taylor, KDHE-BOW.

7 CONTRACTOR'S OR LANDOWNER'S CERTIFICATION: This water well was **1** constructed, (2) reconstructed, or (3) plugged under my jurisdiction and wascompleted on (mo/day/yr) **08/11/06**

and this record is true to the best of my knowledge and belief. Kansas

Water Well Contractor's License No. **692**This Water Well Record was completed on (mo/day/yr) **08/31/06**

under the business name of

Quad State Services, Inc.

by (signature)

INSTRUCTIONS: Please fill in blanks and circle the correct answers. Send three copies to Kansas Department of Health and Environment, Bureau of Water, 1000 S W Jackson St., Ste. 420, Topeka, Kansas 66612-1367. Telephone: 913-296-5545. Send one to WATER WELL OWNER and retain one for your records.