WATER WELL RECORD Form WWC-5 KSA 82a-1212 ID No. SMW-9

1 LOCATION OF WATER WELL: County: Sedgwick | Fraction: NE ¼ NE ¼ SW ¼ | Section Number: 8 | Township Number: T 28 S | Range Number: R 4 E/W

Distance and direction from nearest town or city street address of well if located within city?
101 S. Adams, Cheney, Kansas

2 WATER WELL OWNER: Cheney COOP Elevator Association
RR#, St. Address, Box # : 101 S. Adams
City, State, ZIP Code : Cheney, Kansas 67025
Board of Agriculture, Division of Water Resources Application Number:

3 LOCATE WELL'S LOCATON WITH AN "X" IN SECTION BOX:

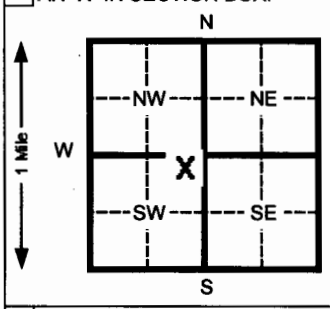

4 DEPTH OF COMPLETED WELL 28.0 ft. ELEVATION:
Depth(s) Groundwater Encountered 1 16.0 ft. 2 ft. 3 ft.
WELL'S STATIC WATER LEVEL 18.00 ft. below land surface measured on mo/day/yr 08/13/06
Pump test data: Well water was ft. after hours pumping gpm
Est. Yield NA gpm: Well water was ft. after hours pumping gpm
Bore Hole Diameter 8.5 in. to 20.0 ft. and 6.5 in. to 30.0 ft.
WELL WATER TO BE USED AS: 1 Domestic 2 Irrigation 3 Feed lot 4 Industrial 5 Public water supply 6 Oil field water supply 7 Lawn and garden (domestic) 8 Air conditioning 9 Dewatering (10) Monitoring well 11 Injection well 12 Other (Specify below)
Was a chemical/bacteriological sample submitted to Department? Yes No X If yes, mo/day/yr sample was submitted
Water Well Disinfected? Yes No X

5 TYPE OF BLANK CASING USED: (2) PVC | 1 Steel | 3 RMP (SR) | 4 ABS | 5 Wrought Iron | 6 Asbestos-Cement | 7 Fiberglass | 8 Concrete tile | 9 Other (specify below)
CASING JOINTS: Glued Clamped Welded Threaded X
Blank casing diameter 2.375 in. to 8.0 ft., Dia in. to ft., Dia in. to ft.
Casing height above land surface Flush Mount in., weight lbs./ft. Wall thickness or gauge No. Schedule 40
TYPE OF SCREEN OR PERFORATION MATERIAL: (7) PVC | 1 Steel | 2 Brass | 3 Stainless steel | 4 Galvanized steel | 5 Fiberglass | 6 Concrete tile | 8 RMP (SR) | 9 ABS | 10 Asbestos-cement | 11 Other (specify) | 12 None used (open hole)
SCREEN OR PERFORATION OPENINGS ARE: 1 Continuous slot | 2 Louvered shutter | (3) Mill slot | 4 Key punched | 5 Gauzed wrapped | 6 Wire wrapped | 7 Torch cut | 8 Saw cut | 9 Drilled holes | 10 Other (specify) | 11 None (open hole)
SCREEN-PERFORATED INTERVALS: From 28.0 ft. to 8.0 ft. From ft. to ft.
From ft. to ft. From ft. to ft.
GRAVEL PACK INTERVALS: From 28.0 ft. to 5.5 ft. From ft. to ft.
From ft. to ft. From ft. to ft.

6 GROUT MATERIAL: 1 Neat cement (2) Cement grout (3) Bentonite 4 Other
Grout Intervals From 0.0 ft. to 1.0 ft. From 1.0 ft. to 5.5 ft. From ft. to ft.
What is the nearest source of possible contamination:
1 Septic tank | 2 Sewer lines | 3 Watertight sewer lines | 4 Lateral lines | 5 Cess pool | 6 Seepage pit | 7 Pit privy | 8 Sewage lagoon | 9 Feedyard | 10 Livestock pens | (11) Fuel storage (former) | 12 Fertilizer storage | 13 Insecticide storage | 14 Abandoned water well | 15 Oil well/ Gas well | 16 Other (specify below)
Direction from well? North-northwest How many feet? 325

FROM	TO	CODE	LITHOLOGIC LOG
0.0	1.0		Black silt, dry
1.0	15.0		Red-brown sand, fine grained
15.0	30.0		Red-brown shale, very hard to extremely hard, dry
			Flush-mount well completion waiver approved by D. Taylor, KDHE-BOW.

7 CONTRACTOR'S OR LANDOWNER'S CERTIFICATION: This water well was (1) constructed, (2) reconstructed, or (3) plugged under my jurisdiction and was completed on (mo/day/yr) 08/12/06 and this record is true to the best of my knowledge and belief. Kansas Water Well Contractor's License No. 692 This Water Well Record was completed on (mo/day/yr) 08/31/06 under the business name of Quad State Services, Inc. by (signature)

INSTRUCTIONS:. Please fill in blanks and circle the correct answers. Send three copies to Kansas Department of Health and Environment, Bureau of Water, 1000 S W Jackson St., Ste. 420, Topeka, Kansas 66612-1367. Telephone: 913-296-5545. Send one to WATER WELL OWNER and retain one for your records.