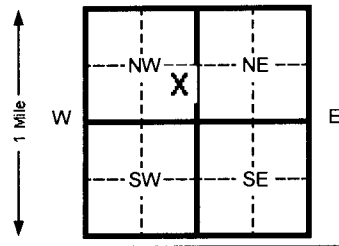


1 LOCATION OF WATER WELL:		Fraction		TOWNSHIP NUMBER		RANGE NUMBER	
County: Sedgwick		NE ¼ SE ¼ NW ¼		Section Number 8		T 28 S 4W 4	
Distance and direction from nearest town or city street address of well if located within city? 126 N. Main, Cheney, Kansas							
2 WATER WELL OWNER: Robert Pipkin							
RR#, St. Address, Box # : 7801 N. Tuttle Creek Circle				Board of Agriculture, Division of Water Resources			
City, State, ZIP Code : Lexington, OK 73051				Application Number:			
3 LOCATE WELL'S LOCATION WITH AN "X" IN SECTION BOX:		4 DEPTH OF COMPLETED WELL 30 ft. ELEVATION:					
		Depth(s) Groundwater Encountered 11.5 ft. 2 _____ ft. 3 _____ ft. WELL'S STATIC WATER LEVEL 16.65 ft. below land surface measured on mo/day/yr 05/29/08 Pump test data: Well water was _____ Ft. after _____ hours pumping _____ Gpm Est. Yield _____ Gpm: Well water was _____ Ft. after _____ Hours pumping _____ Gpm Bore Hole Diameter 8.625 in. to 30 ft. and _____ in. to _____ ft. WELL WATER TO BE USED AS: 5 Public water supply 8 Air conditioning 11 Injection well 1 Domestic 3 Feed lot 6 Oil field water supply 9 Dewatering 12 Other (Specify below) 2 Irrigation 4 Industrial 7 Lawn and garden (domestic) 10 Monitoring well MW-2R Was a chemical/bacteriological sample submitted to Department? Yes _____ No X If yes, mo/day/yr sample was Submitted _____ Water Well Disinfected? Yes _____ No X					
5 TYPE OF BLANK CASING USED:							
1 Steel 3 RMP (SR)		5 Wrought Iron 8 Concrete tile		CASING JOINTS: Glued _____ Clamped _____			
2 PVC 4 ABS		6 Asbestos-Cement 9 Other (specify below)		Welded _____			
		7 Fiberglass		Threaded X			
Blank casing diameter 2 in. to 10 Ft., Dia _____ in. to _____ ft. Dia _____ in. to _____ ft.							
Casing height above land surface FLUSH In., weight SCH 40 Lbs./ft. Wall thickness or gauge No. _____							
TYPE OF SCREEN OR PERFORATION MATERIAL:							
1 Steel 3 Stainless steel 5 Fiberglass		7 PVC 10 Asbestos-cement		8 RMP (SR) 11 Other (specify)			
2 Brass 4 Galvanized steel 6 Concrete tile		9 ABS		12 None used (open hole)			
SCREEN OR PERFORATION OPENINGS ARE:							
1 Continuous slot 3 Mill slot 6 Wire wrapped		5 Gauzed wrapped 8 Saw cut 11 None (open hole)		9 Drilled holes			
2 Louvered shutter 4 Key punched 7 Torch cut		10 Other (specify)					
SCREEN-PERFORATED INTERVALS: From 10 ft. to 30 ft. From _____ ft. to _____ ft.							
SAND PACK INTERVALS: From 9 ft. to 30 ft. From _____ ft. to _____ ft.							
6 GROUT MATERIAL: 1 Neat cement 2 Cement grout 3 Bentonite 4 Other _____							
Grout Intervals From 3 0 ft. to 7 Ft. From 2 7 Ft. to 9 ft. From _____ ft. to _____ ft.							
What is the nearest source of possible contamination:							
1 Septic tank 4 Lateral lines 7 Pit privy		10 Livestock pens 14 Abandoned water well		11 Fuel storage 15 Oil well/ Gas well			
2 Sewer lines 5 Cess pool 8 Sewage lagoon		12 Fertilizer storage 16 Other (specify below)					
3 Watertight sewer lines 6 Seepage pit 9 Feedyard		13 Insecticide storage		Contaminated Site			
Direction from well? _____ How many feet? _____							
7 CONTRACTOR'S OR LANDOWNER'S CERTIFICATION: This water well was (x) constructed, (2) reconstructed, or (3) plugged under my jurisdiction and w							
Completed on (mo/day/yr) 02/12/08 And this record is true to the best of my knowledge and belief. Kansas							
Water Well Contractor's License No. 585 This Water Well Record was completed on (mo/day/yr) 03/07/08							
under the business name of Associated Environmental, Inc. By (signature) Bradley J Johnson							
INSTRUCTIONS: Please fill in blanks and circle the correct answers. Send three copies to Kansas Department of Health and Environment, Bureau of Water, Topeka, Kansas 66620-0001. Telephone: 913-296-5545. Send one to WATER WELL OWNER and retain one for your records.							