


126 N. Main, Cheney, Kansas

Application Number:

Submitted _____ Water Well Disinfected? Yes _____ No **X**

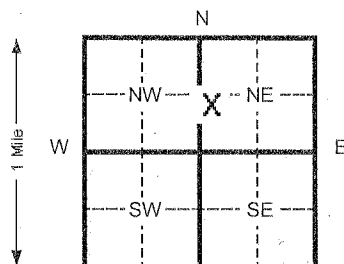

Threaded

	From	ft. to		ft. From	ft. to		Ft.
--	------	--------	--	----------	--------	--	-----

Direction from well? _____ How many feet? _____

[illegible]

INSTRUCTIONS: Please fill in blanks and circle the correct answers. Send three copies to Kansas Department of Health and Environment, Bureau of Water, Topeka, Kansas 66620-0001. Telephone: 913-296-5545. Send one to WATER WELL OWNER and retain one for your records.

and Environment, Bureau of Water, Topeka