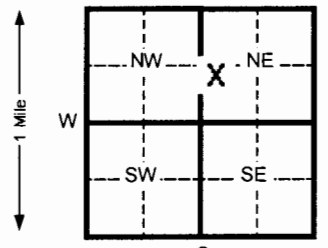


1) LOCATION OF WATER WELL:		Fraction		Section Number		Township Number		Range Number	
County: Sedgwick		NW ¼ SW ¼ NE ¼		8		T 28 S		R 4 W	
Distance and direction from nearest town or city street address of well if located within city? 126 N. Main, Cheney, KS									
2) WATER WELL OWNER: Commercial Lots									
RR#, St. Address, Box # : P.O. Box 2001 Board of Agriculture, Division of Water Resources									
City, State, ZIP Code : Guymon, OK 73949 Application Number:									
3) LOCATE WELL'S LOCATION WITH AN "X" IN SECTION BOX:		4) DEPTH OF COMPLETED WELL 25.416 ft. ELEVATION:							
		Depth(s) Groundwater Encountered 1.5 ft. 2 ft. 3 ft. ft. 4 ft. 