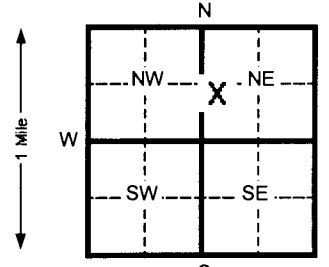


1 LOCATION OF WATER WELL:		Fraction		Section Number		Township Number		Range Number	
County: Sedgwick		NW ¼ SW ¼ NE ¼		8		T 28 S		R 4 W	
Distance and direction from nearest town or city street address of well if located within city? 126 N. Main, Cheney, KS									
2 WATER WELL OWNER: Commercial Lots									
RR#, St. Address, Box # : P.O. Box 2001 Board of Agriculture, Division of Water Resources									
City, State, ZIP Code : Guymon, OK 73949 Application Number:									
3 LOCATE WELL'S LOCATION WITH AN "X" IN SECTION BOX:		4 DEPTH OF COMPLETED WELL 25.75 ft. ELEVATION:							
		Depth(s) Groundwater Encountered 1.5 ft. 2 ft. 3 ft. Ft. WELL'S STATIC WATER LEVEL ft. below land surface measured on mo/day/yr Pump test data: Well water was Ft. after hours pumping Gpm Est. Yield Gpm: Well water was Ft. after Hours pumping Gpm Bore Hole Diameter 8.625 in. to 25.75 ft. and in. to Ft. WELL WATER TO BE USED AS: 5 Public water supply 8 Air conditioning 11 Injection well 1 Domestic 3 Feed lot 6 Oil field water supply 9 Dewatering 12 Other (Specify below) 2 Irrigation 4 Industrial 7 Lawn and garden (domestic) 10 Monitoring well SVE-10 Was a chemical/bacteriological sample submitted to Department? Yes No X If yes, mo/day/yr sample was Submitted Water Well Disinfected? Yes No X							
5 TYPE OF BLANK CASING USED:									
1 Steel 3 RMP (SR) 5 Wrought Iron 8 Concrete tile CASING JOINTS: Glued Clamped 2 PVC 4 ABS 6 Asbestos-Cement 9 Other (specify below) Welded 7 Fiberglass Threaded X									
Blank casing diameter 4 in. to 12 in. Dia. In. to ft., Dia. in. to ft. Casing height above land surface FLUSH In., weight SCH 40 Lbs./ft. Wall thickness or gauge No. TYPE OF SCREEN OR PERFORATION MATERIAL: 7 PVC 10 Asbestos-cement 1 Steel 3 Stainless steel 5 Fiberglass 8 RMP (SR) 11 Other (specify) 2 Brass 4 Galvanized steel 6 Concrete tile 9 ABS 12 None used (open hole) SCREEN OR PERFORATION OPENINGS ARE: 5 Gauzed wrapped 8 Saw cut 11 None (open hole) 1 Continuous slot 3 Mill slot 6 Wire wrapped 9 Drilled holes 2 Louvered shutter 4 Key punched 7 Torch cut 10 Other (specify) SCREEN-PERFORATED INTERVALS: From 12 ft. to 25.75 ft. From ft. to ft. From ft. to ft. From ft. to ft. SAND PACK INTERVALS: From 10 ft. to 25.75 ft. From ft. to ft. From ft. to ft. From ft. to ft.									
6 GROUT MATERIAL: 1 Neat cement 2 Cement grout 3 Bentonite 4 Other									
Grout Intervals From 0.5 ft. to 1 ft. From 1 ft. to 10 ft. From ft. to ft. What is the nearest source of possible contamination: 1 Septic tank 4 Lateral lines 7 Pit privy 10 Livestock pens 14 Abandoned water well 2 Sewer lines 5 Cess pool 8 Sewage lagoon 11 Fuel storage 15 Oil well/ Gas well 3 Watertight sewer lines 6 Seepage pit 9 Feedyard 12 Fertilizer storage 16 Other (specify below) Contaminated Site Direction from well? How many feet?									
FROM TO CODE LITHOLOGIC LOG FROM TO PLUGGING INTERVALS									
0 11 Silty Clay Fill, brown									
11 25.75 Gravel/River Rock									
25.75 TD Shale, End of Borehole									
7 CONTRACTOR'S OR LANDOWNER'S CERTIFICATION: This water well was (x) constructed, (2) reconstructed, or (3) plugged under my jurisdiction and w									
Completed on (mo/day/yr) 12/21/11 And this record is true to the best of my knowledge and belief. Kansas									
Water Well Contractor's License No. 585 This Water Well Record was completed on (mo/day/yr) 02/10/12									
under the business name of Associated Environmental, Inc. By (signature) Bradley J. Johnson									
INSTRUCTIONS: Please fill in blanks and circle the correct answers. Send three copies to Kansas Department of Health and Environment, Bureau of Water, Topeka, Kansas 66620-0001. Telephone: 913-296-5545. Send one to WATER WELL OWNER and retain one for your records.									