


1 LOCATION OF WATER WELL:		Fraction	Section Number	Township Number	Range Number
County:	Sedgwick	SE $\frac{1}{4}$ NE $\frac{1}{4}$ NW $\frac{1}{4}$	8	T 28 S	R 4 W

425 N. Main – Cheney

Board of Agriculture, Division of Water Resources

Application Number:

25 ft. ELEVATION: **1381.56 (surface)**

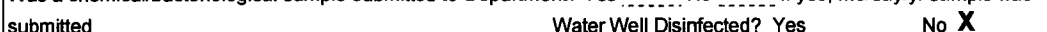

Threaded **Flush**

10 Other (specify)

GRAVEL PACK INTERVALS: From 8 ft. to 25 ft. From _____ ft. to _____ ft.

From	ft. to	ft. From	ft. to	ft.

15 Oil well/ Gas well

16 Other (specify below)

How many feet?

0	5	Silty Clay, brown			
5	25	Shale, red			

						Longitude: W 97.16291

under the business name of **GSI Engineering, LLC** by (signature) *Mr. Chad*

INSTRUCTIONS: Please fill in blanks and circle the correct answers. Send three copies to Kansas Department of Health and Environment, Bureau of Water, 1000 S W Jackson St., Ste. 420, Topeka, Kansas 66612-1367. Telephone: 913-296-5545. Send one to WATER WELL OWNER and retain one for your records.