

WATER WELL PLUGGING RECORD

Form WWC-5P

KSA 82a-1212

ID NO.


MW5R

1 LOCATION OF WATER WELL: County: Sedgwick Fraction 1/4 SE 1/4 NE 1/4 NW 1/4 Section Number 8 Township Number T 28 S Range Number 4 E X W

Street/Rural Address of Well Location; if unknown, distance & direction from nearest town or intersection: If at owner's address, check here 425 N. Main, Cheney, KS

Global Positioning Systems (GPS) information: Latitude: NA Longitude: NA Elevation: NA Horizontal Datum WGS84, NAD83, NAD27 Collection Method: GPS unit Digital Map/Photo, Topographic Map, Land Survey Est. Accuracy: <3 m, 3-5 m, 5-15 m, >15 m

2 WATER WELL OWNER: KDHE RR#, St. Address, Box #: 1000 SW Jackson Blvd City, State ZIP Code: Topeka, KS 66612

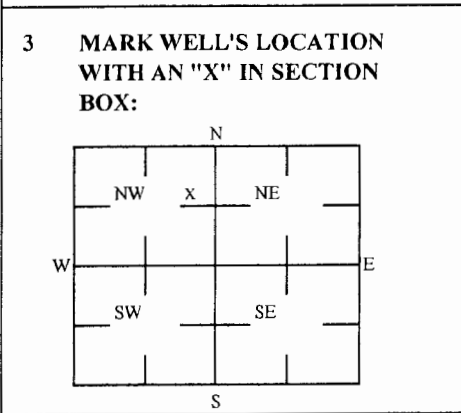

4 DEPTH OF WELL 24.7 ft. MW5R WELL'S STATIC WATER LEVEL NA ft WELL WAS USED AS: Domestic, Irrigation, Feedlot, Industrial, Public Water Supply, Oil Field Water Supply, Domestic (Lawn & Garden), Air Conditioning, Dewatering, Monitoring, Injection Well, Other Was a chemical/bacteriological sample submitted to Department? Yes No X

5 TYPE OF BLANK CASING USED: Steel, PVC, RMP (SR), ABS, Wrought, Asbestos-Cement, Fiberglass, Concrete Tile, Other (Specific below) Blank casing diameter 2 in. Casing height above or below land surface NA in. Was casing pulled? Yes X No If yes, how much 3'

6 GROUT PLUG MATERIAL: Neat cement, Cement grout, Bentonite, Other Asphalt: 0-0.5'; Soil: 0.5-1' Grout Plug Intervals: From 1 ft to 24.7 ft, From ft to ft, From ft to ft What is the nearest source of possible contamination: Septic tank, Sewer lines, Watertight sewer lines, Lateral lines, Cess pool, Seepage pit, Pit privy, Sewage lagoon, Feed yard, Livestock pens, Fuel storage, Fertilizer storage, Insecticide storage, Abandoned water well, Oil well/Gas well, Other (specify below) Direction from well? How many feet?

Table with 6 columns: FROM, TO, PLUGGING MATERIALS, FROM, TO, PLUGGING MATERIALS. Rows show grout plug intervals: 0-0.5 ft (Asphalt), 0.5-1 ft (Soil), 1-24.7 ft (Bentonite). KDHE ID: Sav-A-Trip #8: U2-087-13890

7 CONTRACTOR'S OR LANDOWNER'S CERTIFICATION: This water well was plugged under my jurisdiction and was completed on (mo/day/year) 8/2/2017 and this record is true to the best of my knowledge and belief. Kansas Water Contractor's License No. 757. This Water Well Record was completed on (mo/day/year) 8/21/2017 under the business name of Larsen & Associates, Inc. By (signature)

Send one white copy to Kansas Department of Health & Environment, Geology Section, 1000 SW Jackson Street, Ste. 420, Topeka, KS 66612-1367. Send one copy to WATER WELL OWNER and retain one for your records Visit us at http://www.kdheks.gov/waterwell/index.html Telephone 785-296-5524.