

**WATER WELL RECORD Form WWC-5**
☐ Original Record   ☐ Correction   ☐ Change in Well Use
Division of Water  
Resources App. No.

Well ID

**1 LOCATION OF WATER WELL:**

County:

Fraction

 $\frac{1}{4}$  $\frac{1}{4}$  $\frac{1}{4}$  $\frac{1}{4}$ 

Section Number

Township Number

T

S

Range Number

R

☐ E☐ W**2 WELL OWNER:** Last Name:

First:

Business:

Address:

Address:


City:

State:

ZIP:

Street or Rural Address where well is located (if unknown, distance and direction from nearest town or intersection): If at owner's address, check here: ☐**3 LOCATE WELL WITH "X" IN SECTION BOX:**

N

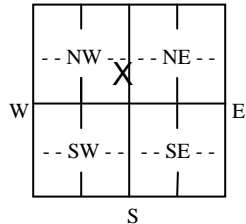

S

|-----1 mile-----|

**4 DEPTH OF COMPLETED WELL:** ..... ft.

Depth(s) Groundwater Encountered: 1) ..... ft.

2) ..... ft. 3) ..... ft., or 4) ☐ Dry Well

WELL'S STATIC WATER LEVEL: ..... ft.

☐ below land surface, measured on (mo-day-yr).....☐ above land surface, measured on (mo-day-yr).....

Pump test data: Well water was ..... ft.

after..... hours pumping ..... gpm

Well water was ..... ft.

after..... hours pumping ..... gpm

Estimated Yield: .....gpm

Bore Hole Diameter: ..... in. to ..... ft. and

..... in. to ..... ft.

**5 Latitude:** .....(decimal degrees)**Longitude:** .....(decimal degrees)Datum: ☐ WGS 84   ☐ NAD 83   ☐ NAD 27

Source for Latitude/Longitude:

☐ GPS (unit make/model: .....)(WAAS enabled? ☐ Yes   ☐ No)☐ Land Survey   ☐ Topographic Map☐ Online Mapper: .....**6 Elevation:** .....ft. ☐ Ground Level   ☐ TOCSource: ☐ Land Survey   ☐ GPS   ☐ Topographic Map☐ Other .....**7 WELL WATER TO BE USED AS:**

1. Domestic:

☐ Household☐ Lawn & Garden☐ Livestock2. ☐ Irrigation3. ☐ Feedlot4. ☐ Industrial5. ☐ Public Water Supply: well ID .....6. ☐ Dewatering: how many wells? .....7. ☐ Aquifer Recharge: well ID .....8. ☐ Monitoring: well ID .....

9. Environmental Remediation: well ID .....

☐ Air Sparge   ☐ Soil Vapor Extraction☐ Recovery   ☐ Injection10. ☐ Oil Field Water Supply: lease .....

11. Test Hole: well ID .....

☐ Cased   ☐ Uncased   ☐ Geotechnical

12. Geothermal: how many bores? .....

a) Closed Loop   ☐ Horizontal   ☐ Verticalb) Open Loop   ☐ Surface Discharge   ☐ Inj. of Water13. ☐ Other (specify): .....Was a chemical/bacteriological sample submitted to KDHE? ☐ Yes   ☐ No   If yes, date sample was submitted: .....Water well disinfected? ☐ Yes   ☐ No**8 TYPE OF CASING USED:** ☐ Steel   ☐ PVC   ☐ Other ..... CASING JOINTS: ☐ Glued   ☐ Clamped   ☐ Welded   ☐ Threaded

Casing diameter ..... in. to ..... ft., Diameter ..... in. to ..... ft., Diameter ..... in. to ..... ft.

Casing height above land surface ..... in.   Weight ..... lbs./ft.   Wall thickness or gauge No. ....

## TYPE OF SCREEN OR PERFORATION MATERIAL:

☐ Steel   ☐ Stainless Steel☐ PVC☐ Other (Specify) .....☐ Brass   ☐ Galvanized Steel☐ None used (open hole)

## SCREEN OR PERFORATION OPENINGS ARE:

☐ Continuous Slot   ☐ Mill Slot   ☐ Gauze Wrapped   ☐ Torch Cut   ☐ Drilled Holes   ☐ Other (Specify) .....☐ Louvered Shutter   ☐ Key Punched   ☐ Wire Wrapped   ☐ Saw Cut   ☐ None (Open Hole)

SCREEN-PERFORATED INTERVALS: From ..... ft. to ..... ft., From ..... ft. to ..... ft., From ..... ft. to ..... ft.

GRAVEL PACK INTERVALS: From ..... ft. to ..... ft., From ..... ft. to ..... ft., From ..... ft. to ..... ft.

**9 GROUT MATERIAL:** ☐ Neat cement   ☐ Cement grout   ☐ Bentonite   ☐ Other .....

Grout Intervals: From ..... ft. to ..... ft., From ..... ft. to ..... ft., From ..... ft. to ..... ft.

Nearest source of possible contamination: No potential source of contamination within 200 ft.

☐ Septic Tank☐ Lateral Lines☐ Pit Privy☐ Livestock Pens☐ Insecticide Storage☐ Sewer Lines☐ Cess Pool☐ Sewage Lagoon☐ Fuel Storage☐ Abandoned Water Well☐ Watertight Sewer Lines☐ Seepage Pit☐ Feedyard☐ Fertilizer Storage☐ Oil Well/Gas Well☐ Other (Specify) .....

Direction from well? ..... Distance from well? ..... ft.

**10 FROM TO LITHOLOGIC LOG FROM TO LITHO. LOG (cont.) or PLUGGING INTERVALS**


**Notes:**

**11 CONTRACTOR'S OR LANDOWNER'S CERTIFICATION:** This water well was ☐ constructed, ☐ reconstructed, or ☐ plugged under my jurisdiction and was completed on (mo-day-year) ..... and this record is true to the best of my knowledge and belief. Kansas Water Well Contractor's License No. .... This Water Well Record was completed on (mo-day-year) ..... under the business name of .....


Send one copy to WATER WELL OWNER and retain one for your records. Fee of \$5.00 for each constructed well.



KS Department of Health and Environment, Bureau of Water, Geology Section, 1000 SW Jackson St., Suite 420, Topeka, Kansas 66612-1367. Telephone 785-296-3565.

Visit us at <http://www.kdheks.gov/waterwell/index.html>



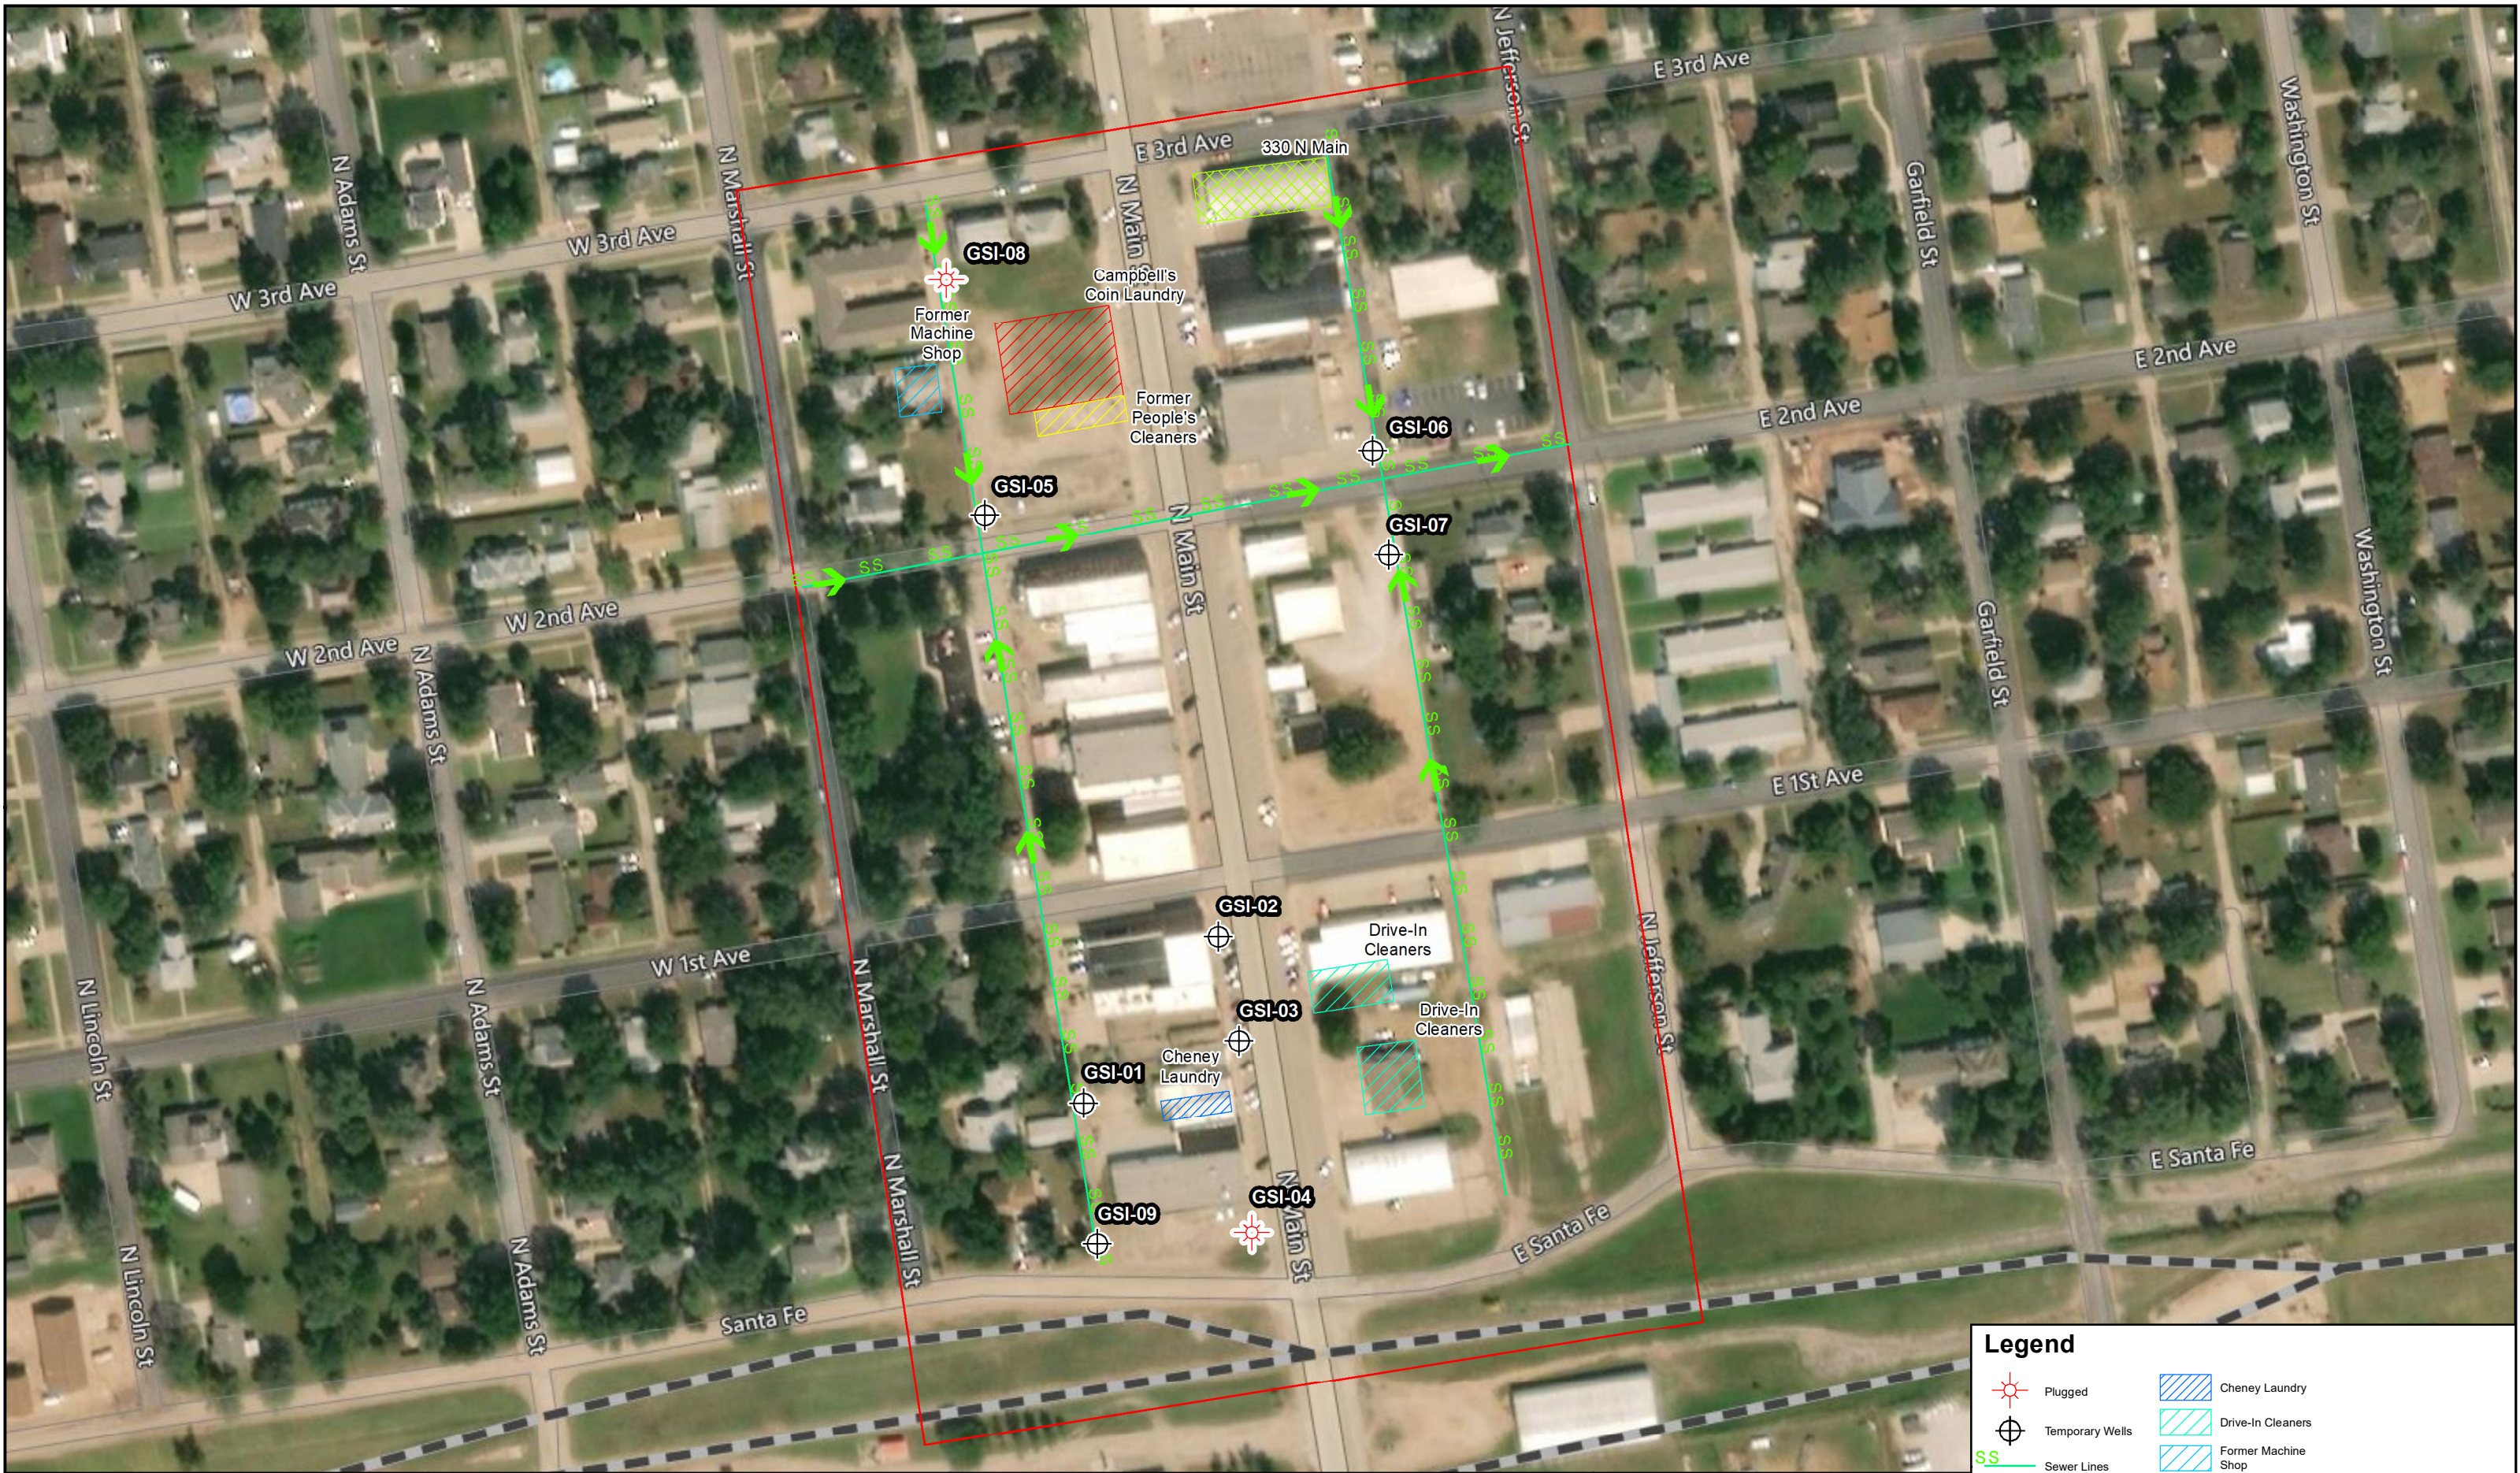







KSA 82a-1212





	FIGURE: <b>2.0</b>	FIGURE NAME: <b>Site Base Map</b>	<b>Cheney PCE</b> <b>Cheney, KS</b> <b>KDHE#: C2-087-72860</b>	<div>Feet 0 75 150 1 in = 150 feet</div> 
	DATE: <b>12/28/20</b>	PROJECT NUMBER: <b>2074028</b>		
	DRAWN BY: <b>PM</b>	PROJECT MANAGER: <b>M. Balleau</b>		

**Legend**

	Plugged		Cheney Laundry
	Temporary Wells		Drive-In Cleaners
	Sewer Lines		Former Machine Shop
	330 N Main		Former People's Cleaners
	Campbell's Coin Laundry		Site_Boundary

ALL BOUNDARIES AND LOCATIONS ARE APPROXIMATE