

**WATER WELL RECORD      Form WWC-5**


☐ Original Record    ☐ Correction    ☐ Change in Well Use



Division of Water  
Resources App. No.

Well ID



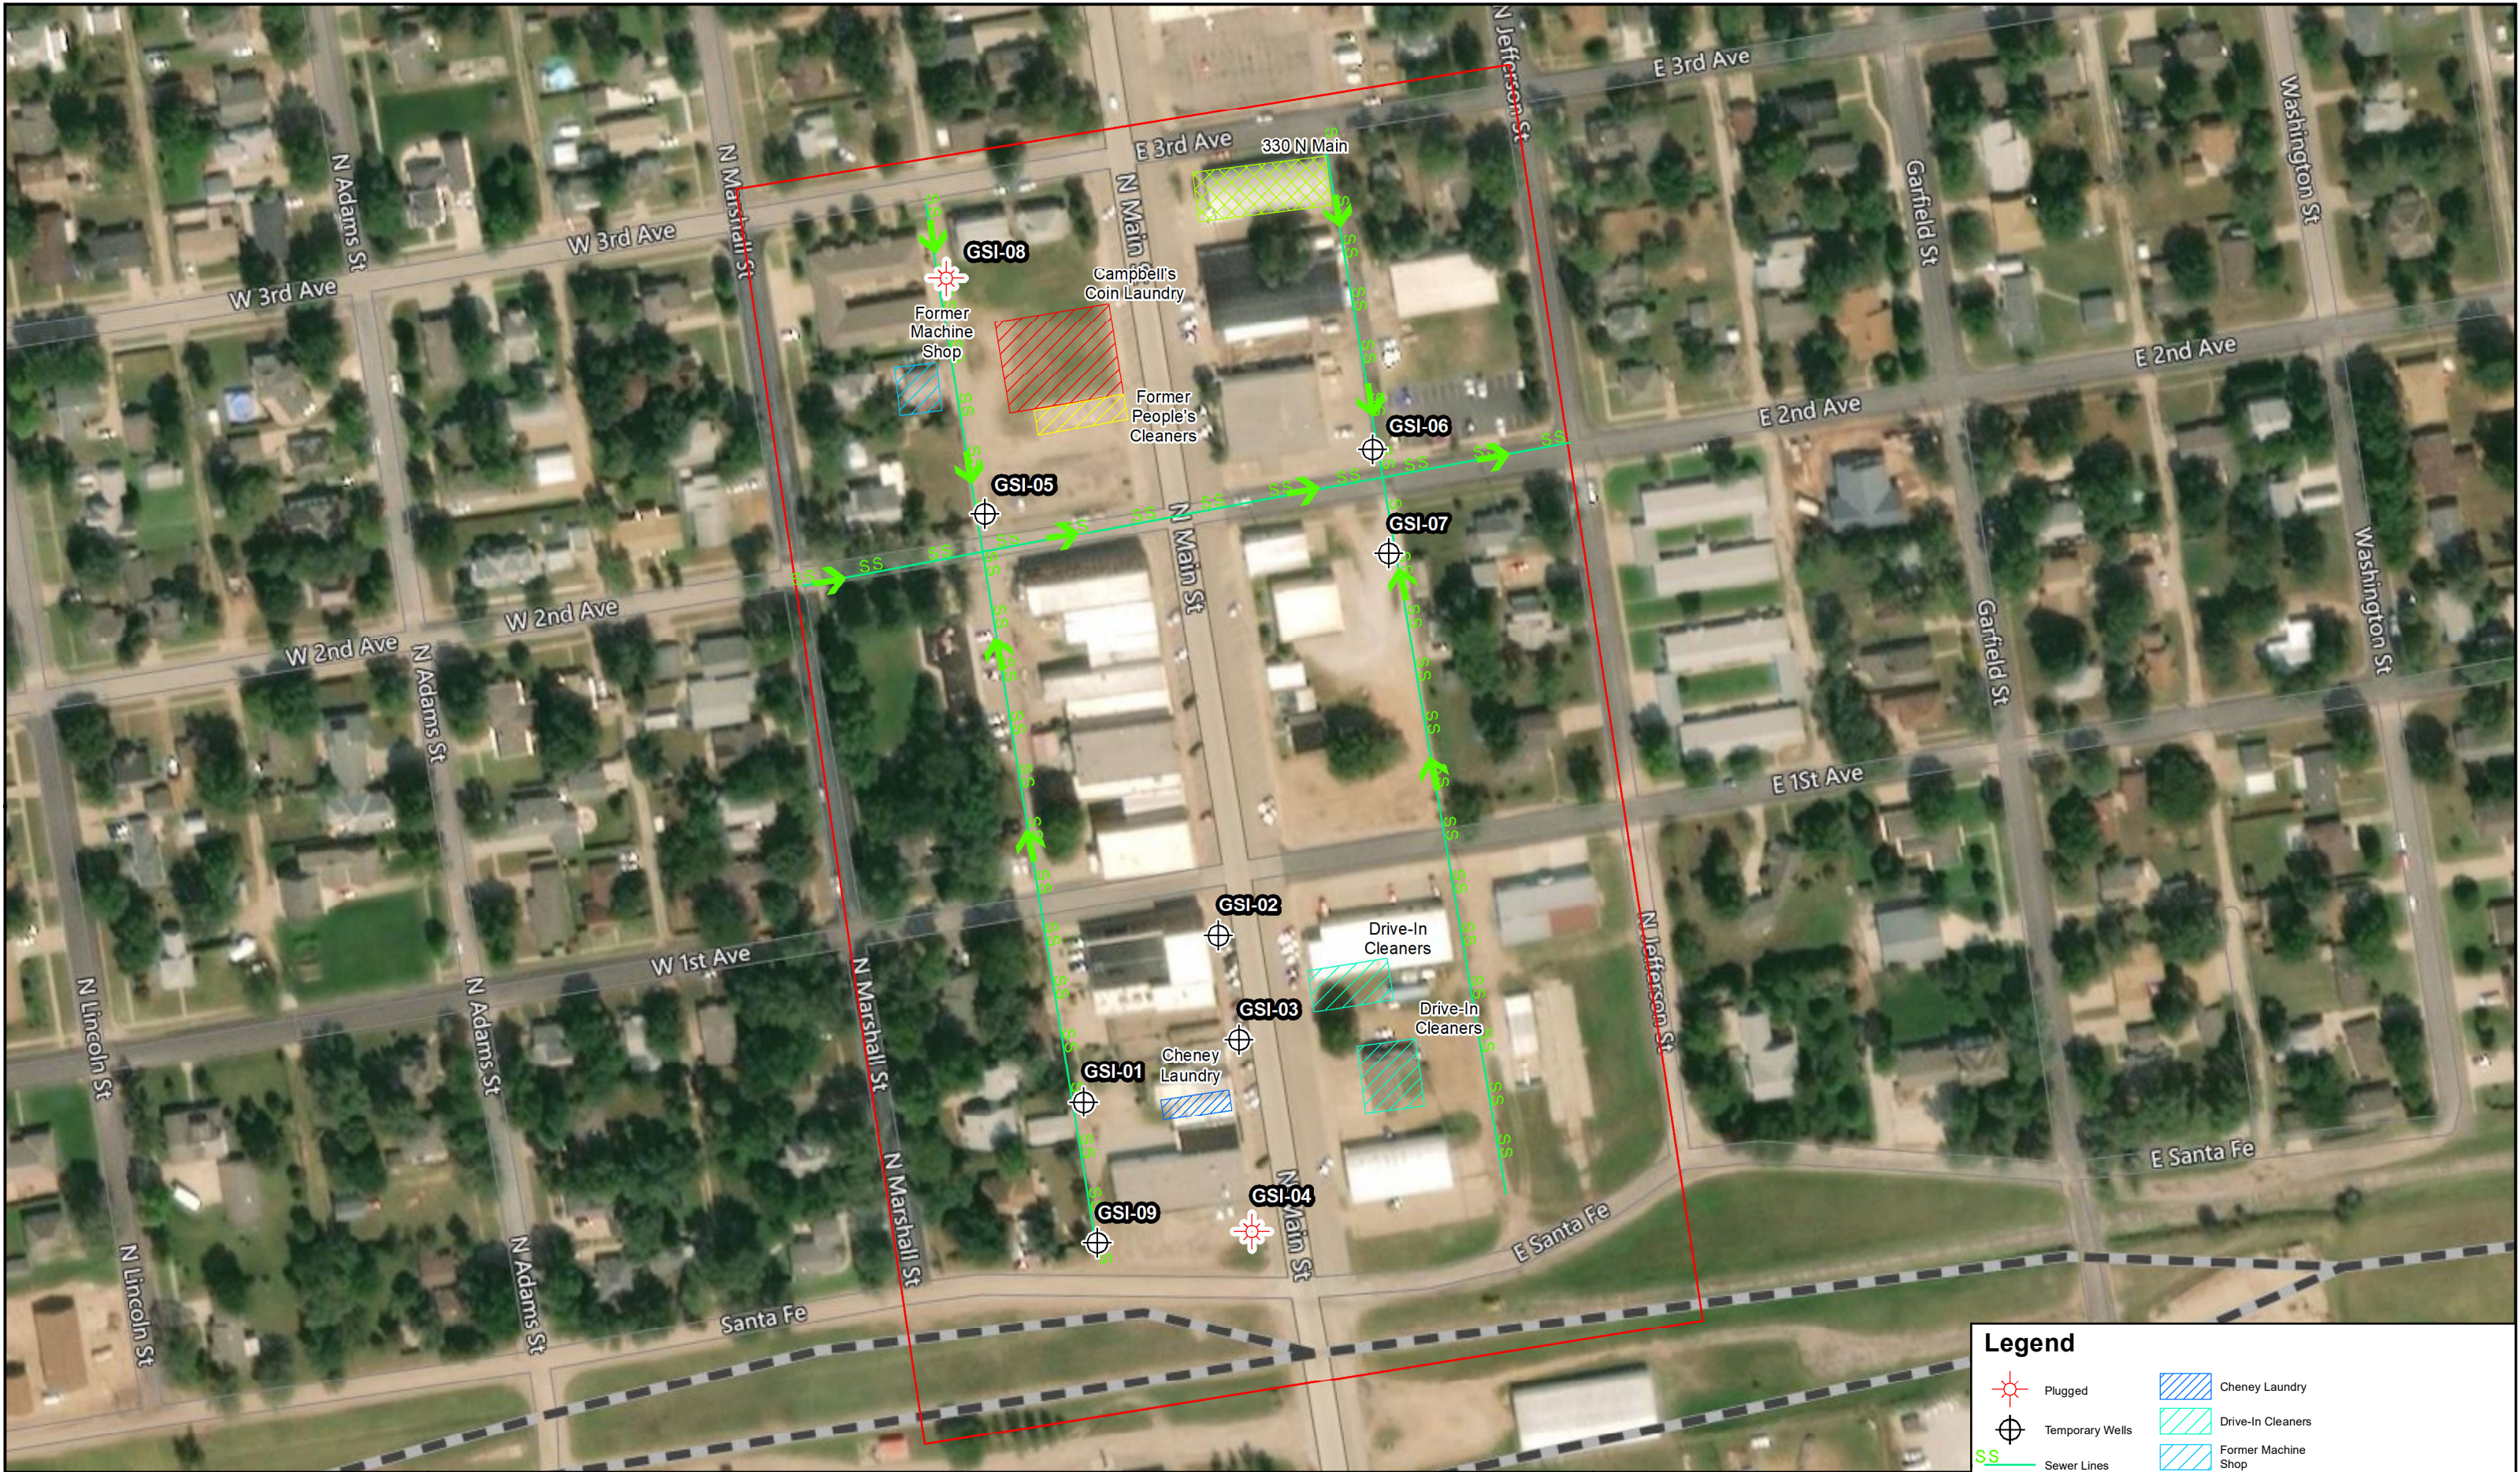







[illegible]





	FIGURE: <b>2.0</b>	FIGURE NAME: <b>Site Base Map</b>	<b>Cheney PCE</b> <b>Cheney, KS</b> <b>KDHE#: C2-087-72860</b>	<div>Feet 0 75 150 1 in = 150 feet</div> 
	DATE: <b>12/28/20</b>	PROJECT NUMBER: <b>2074028</b>		
	DRAWN BY: <b>PM</b>	PROJECT MANAGER: <b>M. Balleau</b>		

**Legend**

	Plugged		Cheney Laundry
	Temporary Wells		Drive-In Cleaners
	Sewer Lines		Former Machine Shop
	330 N Main		Former People's Cleaners
	Campbell's Coin Laundry		Site_Boundary

ALL BOUNDARIES AND LOCATIONS ARE APPROXIMATE