




WATER WELL RECORD Form WWC-5☐ Original Record ☐ Correction ☐ Change in Well Use

Division of Water
Resources App. No.



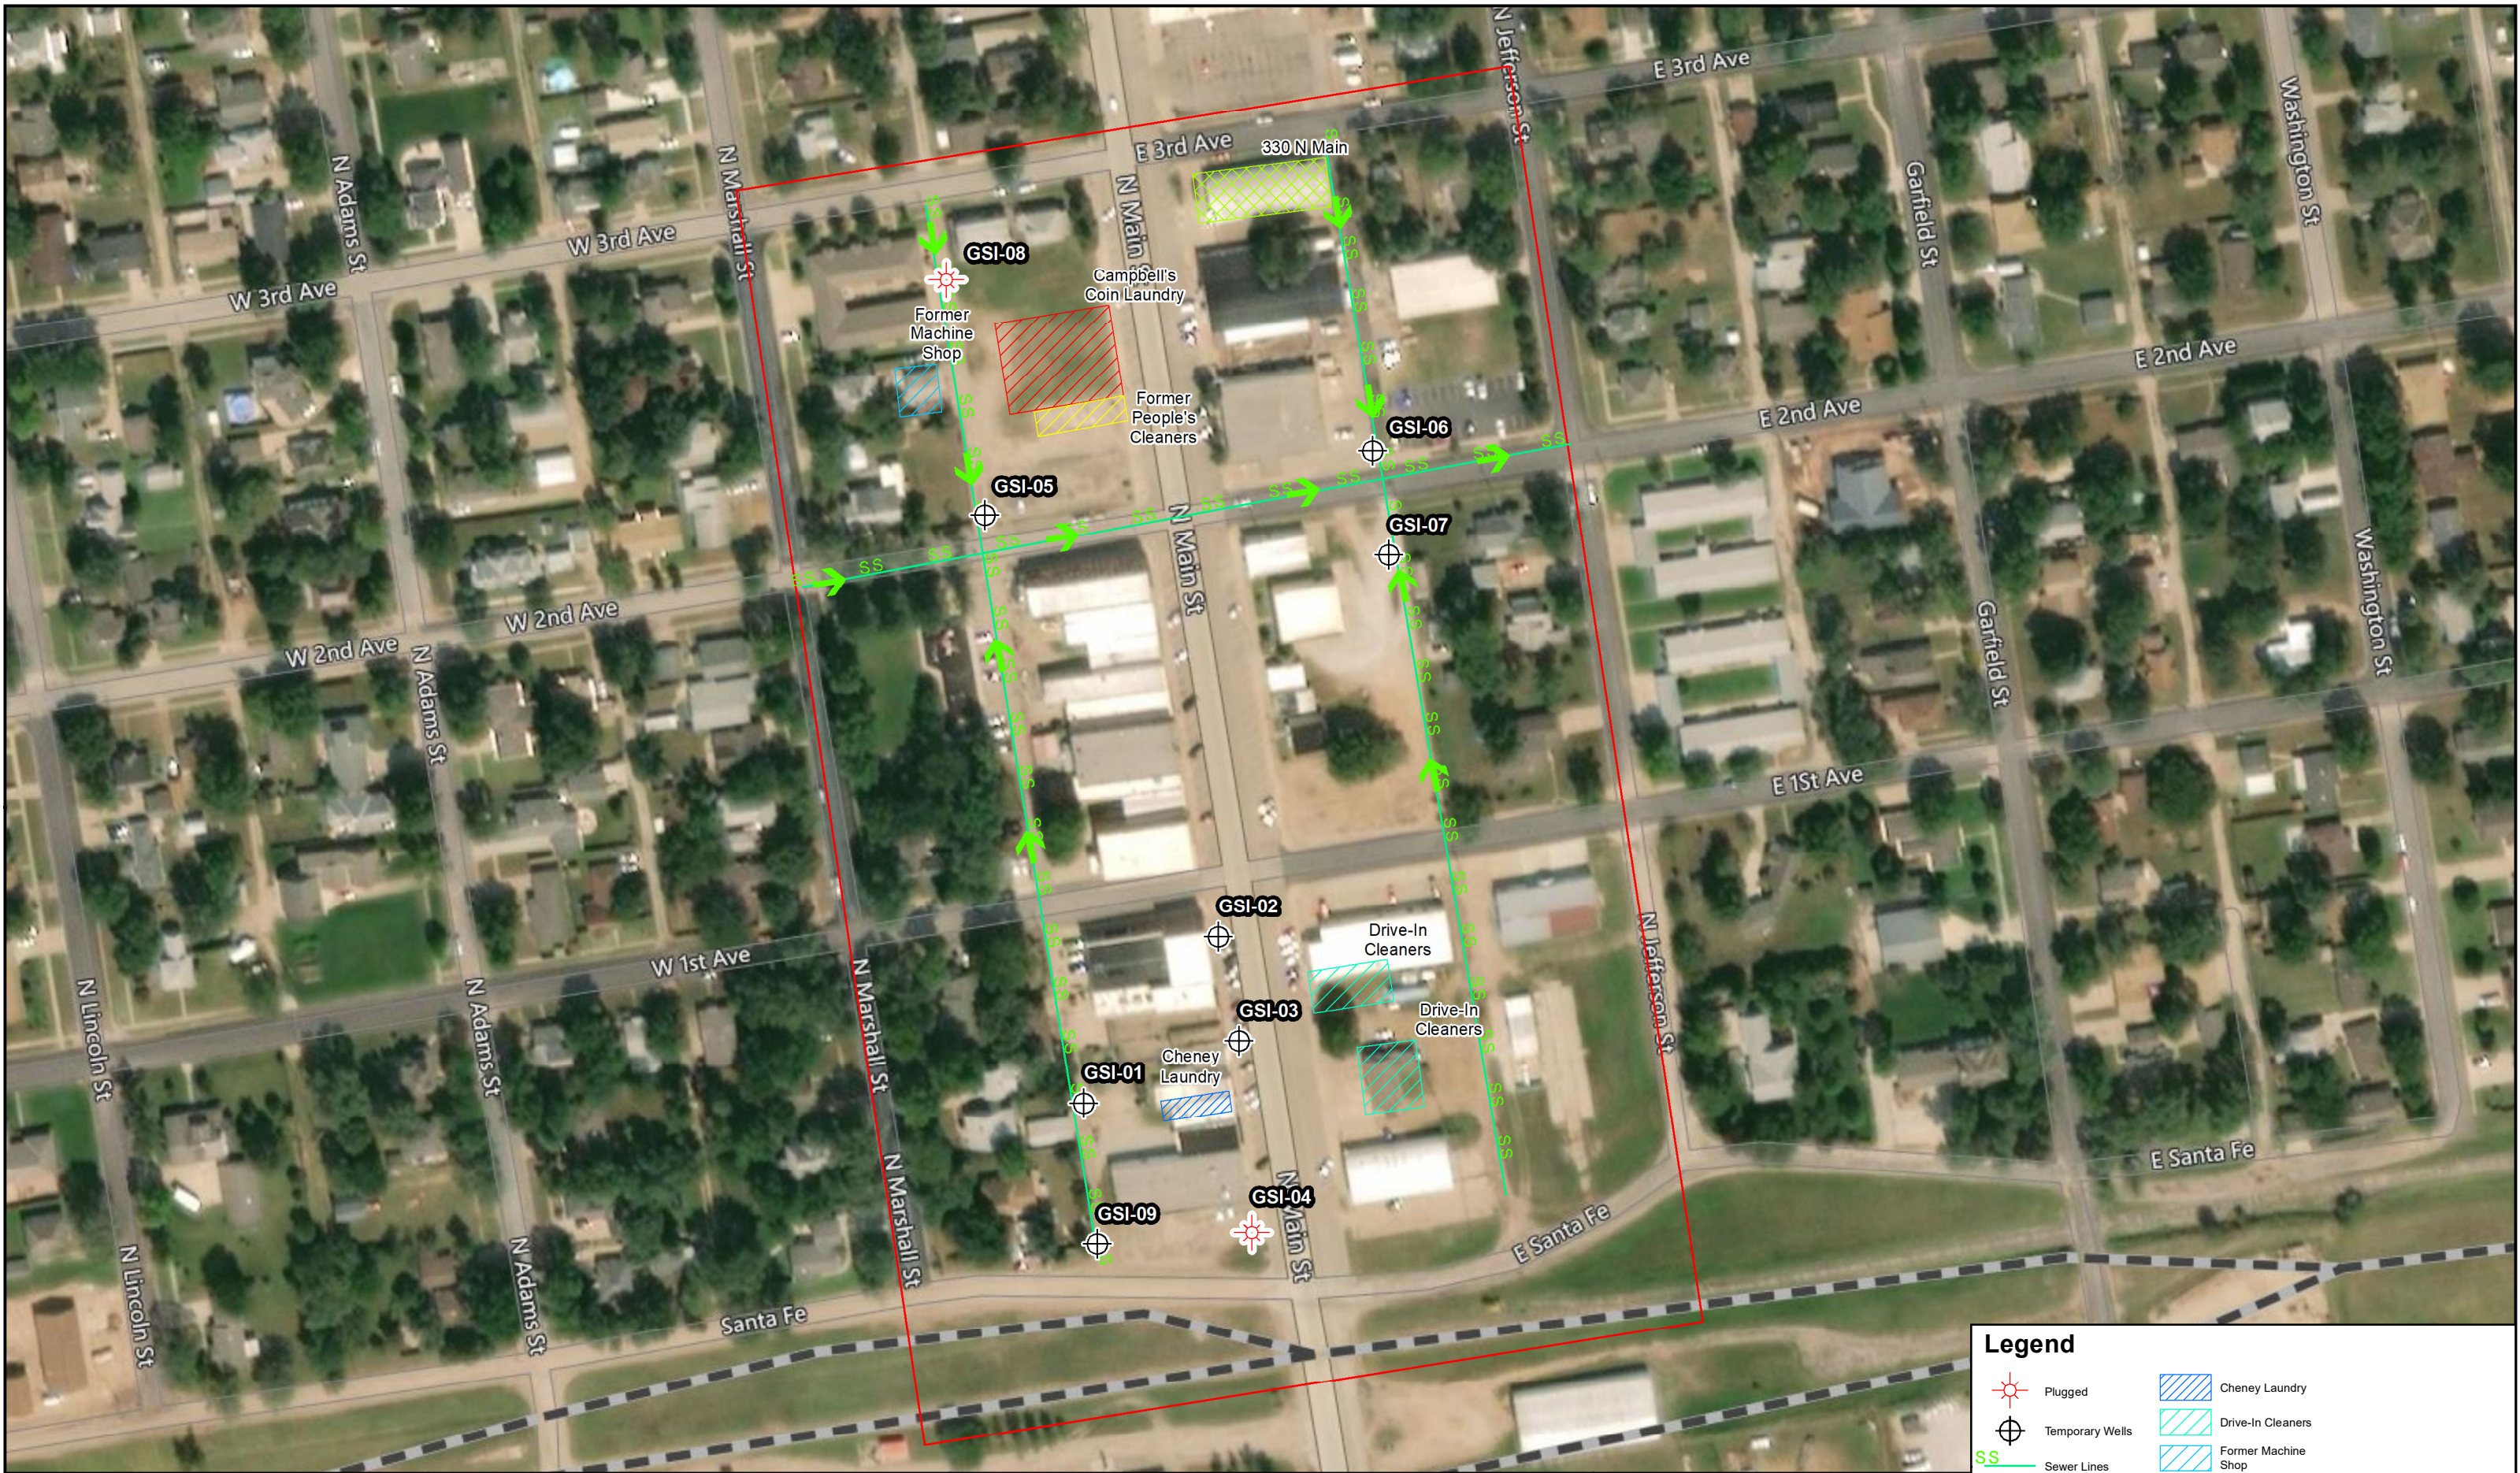







Well ID

[illegible]



	FIGURE: 2.0	FIGURE NAME: Site Base Map	Cheney PCE Cheney, KS KDHE#: C2-087-72860	<div>Feet 0 75 150 1 in = 150 feet</div> 
	DATE: 12/28/20	PROJECT NUMBER: 2074028		
	DRAWN BY: PM	PROJECT MANAGER: M. Balleau		

Legend

	Plugged		Cheney Laundry
	Temporary Wells		Drive-In Cleaners
	Sewer Lines		Former Machine Shop
	330 N Main		Former People's Cleaners
	Campbell's Coin Laundry		Site_Boundary

ALL BOUNDARIES AND LOCATIONS ARE APPROXIMATE