TO BWS 5-12-78

USE TYPEWRITER OR BALL POINT PEN-PRESS FIRMLY, PRINT CLEARLY.

WATER WELL RECORD
KSA 82a-1201-1215

Kansas Department of Health and Environment-Division of Environment
(Water well Contractors)
Topeka, Kansas 66620

1. Location of well:	County	Fraction	Section number	Township number	Range number
	Sedgwick	SW 1/4 NW 1/4 SW 1/4	5	T 28 S	R 4 E/W

2. Distance and direction from nearest town or city: 1960' N. & 75' E. of SW Corner 1/4 mi. N. of Cheney
Street address of well location if in city:

3. Owner of well: City of Cheney
R.R. or street:
City, state, zip code: Cheney, Kansas 67025

4. Locate with "X" in section below:

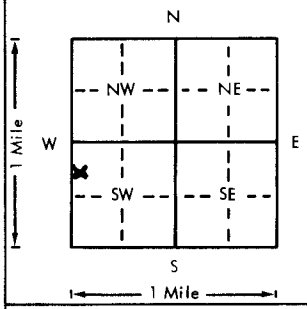

Sketch map:

Well No. 7 (TH 5-77)

5. Type and color of material	From	To
Sandy top soil	0	2
Brown clay	2	31
Med. to coarse sand & gravel	31	39'6"
Mlti-color shale	39'6"	90
Blue shale	90	95

(Use a second sheet if needed)

6. Bore hole dia. 39" & 15" in. Completion date 5/2/78
Well depth 93 ft.

7. __ Cable tool __ Rotary __ Driven __ Dug
__ Hollow rod __ Jetted __ Bored X Reverse rotary

8. Use: __ Domestic X Public supply __ Industry
__ Irrigation __ Air conditioning __ Stock
__ Lawn __ Oil field water __ Other

9. Casing: Material Stl Height: Above ~~below~~
Threaded ___ Welded X Surface 42 in.
RMP ___ PVC X Weight 62.58 lbs./ft.
Dia. 16 in. to 46 ft. depth Wall Thickness: inches or
Dia. 12 in. to 93 ft. depth gage No. .375"

10. Screen: Manufacturer's name Mustang & Peerless Plastics
Type Stainless & PVC Dia. 16 & 12
Slot/gauze 60 & .0625 Length 8' & 52'
Set between 31.5 ft. and 39.5 ft.
41 ft. and 93 ft.
Gravel pack? Yes Size range of material 1/8-1/4"

11. Static water level: mo./day/yr.
11.5 ft. below land surface Date 5/2/78

12. Pumping level below land surfaces:
30 ft. after 4 hrs. pumping 115 g.p.m.
___ ft. after ___ hrs. pumping ___ g.p.m.
Estimated maximum yield 100 g.p.m.

13. Water sample submitted: mo./day/yr.
___ Yes X No Date

14. Well head completion:
___ Pitless adapter 42 Inches above grade

15. Well grouted? yes
With: ___ Neat cement ___ Bentonite X Concrete
Depth: From 0 ft. to 20 ft.

16. Nearest source of possible contamination:
ft. 1000 Direction South Type House
Well disinfected upon completion? X Yes ___ No

17. Pump: X Not installed
Manufacturer's name
Model number ___ HP ___ Volts ___
Length of drop pipe ___ ft. capacity ___ g.p.m.
Type:
___ Submersible ___ Turbine
___ Jet ___ Reciprocating
___ Centrifugal ___ Other

18. Elevation:

Topography:
___ Hill
___ Slope
X Upland
___ Valley

19. Remarks:

20. Water well contractor's certification:
This well was drilled under my jurisdiction and this report is true to the best of my knowledge and belief.
Layne Western Co. 102
Business name License No.
Address Wichita, Kansas
Signed [signature] Date 5/10/78
Authorized representative

T 28 S — R 4 E (W) — Sec 5 — 1/4 SW 1/4 NW 1/4 SW 1/4

Forward the white, blue and pink copies to the Department of Health and Environment

Form WWC-5

M1-1023